

ADDENDUM NO. 02 Issued: MARCH 5, 2021 THE SEAL APPEARING ON THIS DOCUMENT WAS AUTHORIZED BY JUAN CANTU, AIA 28594 DATED MARCH 5, 2021

To Plans and Specifications dated FEBRUARY 12, 2021.

SAN CARLOS ELEMENTARY GYMNASIUM ADDITION EDINBURG CISD

ERO Project No.: 20042

NOTICE TO PROPOSERS



- A. Receipt of this Addendum shall be acknowledged on the Proposal Form.
- B. This Addendum forms part of the Contract documents for the above referenced project and shall be incorporated integrally therewith.
- C. Each proposer shall make necessary adjustments and submit his proposal with full knowledge of all modifications, clarifications, and supplemental data included therein. Where provisions of the following supplemental data differ from those of the original Contract Documents, this Addendum shall govern.
- D. This addendum is generally separated into sections for convenience; however, all contractors, subcontractors, material men and other parties shall be responsible for reading the entire addendum. The failure to list an item or items in all affected sections of this addendum does not relieve any party affected from performing as per instructions, providing that the information is set forth one time in this addendum.

PROJECT MANUAL

Item No. S01	Project Manual, Division 11 – Gymnasium Equipment, Section 11 66 23, Parts 2 Products 2.01 Manufacturer: Acceptable Manufacturer ALLCO Manufacturing
Item No. S02	Project Manual, Division 13 – Metal Building Systems, Section 13 34 19, Parts 2 Products 2.01 Manufacturer: Acceptable Manufacturer Strong Structural Steel, Ltd.
Item No. S03	Project Manual, Division 26 – Lighting Controls, Section 26 09 23, Parts 2 Products 2.01 Manufacturers: Acceptable Manufacturer Replace specifications in its entirety. Refer to attachment.
PLANS	
Item No. P01	 Sheet MP01 – MECHANICAL FLOOR PLAN – Replace this sheet in its entirety. Main return air grilles changed in size to 36"x20" Added keved notes to:

- a) Office A113 transfer grille into Gymnasium A101.
- b) Supply air devices serving Storage A114.
- 3. Revised keyed notes for fabric duct, outside duct, and outside duct stands.

Item No. P02 Sheet MP02 – MECHANICAL SECTIONS – Replace this sheet in its entirety. 1. Revised sections in relation to above mentioned grilles and keyed notes Item No. P03 Sheet EG01 – ELECTRICAL LEGEND – Replace this sheet in its entirety.

1. Lighting electrical information was modified to match model number. Lighting Fixture Schedule Notes: Lighting Manufacturers that can be used as acceptable manufactures was modified. Acceptable lighting manufacturers are as follows: Refer to attached.

Item No. P04 Sheet EL01 – ELECTRICAL FLOOR PLAN – Replace this sheet in its entirety.

- 1. Data drops were added with mounting heights with revised keyed notes. All locations and mounting heights shall be coordinated with owner/district prior to installation.
- 2. Speaker infrastructure was added. Refer to attachment.
- 3. General note added to coordinate all new electrical devices shown in plan with owner/district. Refer to attachment.
- 4. Disconnect location for stepdown transformer is now shown on plans.
- Detail #1 Electrical lighting plan, All light switches shall include a 277V circuit for the lighting controls. The circuit shall be H-42. Provide1-20Amp 1- pole breaker, wiring shall be 2#10, 1#10G, ¾"C.

Item No. P05 Sheet ER01 – ELECTRICAL RISER – Replace this sheet in its entirety.

1. Wiring for SPD shall be 4#10, 1#10G, ¾"C and wiring for H-11 shall be 2#10, 1#10G, ¾"C was added. Refer to attachment.

END OF ADDENDUM NO. 2 (25 pages of Attachments Follow)



P: 956.973.0500 | F: 956.351.5750 www.trinitymep.com | Copyright 2021 Texas Registered Engineering Firm No. - F10362

ADDENDUM #2



Architect: ERO Architects Project Name: San Carlos Gymnasium Addition Project Number: 20.4.18

Date: 3/5/2021

Note: The work shall be carried out in accordance with the following supplemental instructions issued in accordance with the Contract Documents without change in Contract Sum or Contract Time Proceeding with the Work in accordance with these instructions indicates your acknowledgement that there will be no change in the Contract Sum or Contract Time.

- I. Specifications:
 - A. Section 260923 Lighting Control added acceptable manufacturers, refer to attachment.
- II. General: N/A
- III. Mechanical:
 - A. Sheet MP01 the following revisions were made to this sheet, refer to attached:
 - 1. Main return air grilles changed in size to 36" x20".
 - 2. Added keyed notes to:
 - a. OFFICE A113 transfer grille into GYMNASIUM A101.
 - b. Supply air devices serving STORAGE A114.
 - 3. Revised keyed notes for fabric duct, outside duct, and outside duct stands.
 - B. Sheet MP02 revised sections in relation to above mentioned grilles and keyed notes.
- IV. Electrical:
 - A. Sheet EL01 Data drops were added with mounting heights with revised keyed notes. All Devices locations and mounting heights shall be coordinated with owner/district prior any installations. Refer to attachment.
 - B. Sheet EL01 Speaker infrastructure was added. Refer to attachment.
 - C. Sheet EL01 General note added to coordinate all new electrical devices shown in plan with owner/district. Refer to attachment.
 - D. Sheet EL01- Disconnect location for stepdown transformer is now shown on plans. Refer to attachment.



P: 956.973.0500 | F: 956.351.5750 www.trinitymep.com | Copyright 2021 Texas Registered Engineering Firm No. - F10362

- E. Sheet ER01- Wiring for SPD shall be 4#10, 1#10G, 3/4"C and wiring for H-11 shall be 2#10, 1#10G, 3/4"C was added. Refer to attachment.
- F. Sheet EG01- Lighting electrical information was modified to match model number. Lighting Fixture Schedule Notes: Lighting Manufacturers that can be used as acceptable manufacturers was modified. Acceptable lighting manufacturers are as follows: Refer to attached.
- G. Sheet EL01 Detail #1 Electrical lighting plan, All light switches shall include a 277V circuit for the lighting controls. The circuit shall be H-42. Provide 1-20Amp 1pole breaker, wiring shall be 2#10, 1#10G, ¾"C.
- V. Plumbing: N/A
- VI. Fire Protection:

SECTION 26 0923 LIGHTING CONTROLS

PART 1 GENERAL

1.01 SECTION INCLUDES

- A. Single space wireless lighting control systems and associated components:
 - 1. Wireless occupancy/vacancy sensors.
 - 2. Wireless control stations.
- B. Wireless hub(s) for centralized control, monitoring, and system integration.

1.02 RELATED REQUIREMENTS

A. Section - *Identification for Electrical Systems*: Identification products and requirements.

1.03 REFERENCE STANDARDS

- A. 47 CFR 15 Radio Frequency Devices; *current edition*.
- B. ANSI C82.11 American National Standard for Lamp Ballasts High Frequency Fluorescent Lamp Ballasts Supplements; 2011.
- C. ANSI/ESD S20.20 Protection of Electrical and Electronic Parts, Assemblies and Equipment (Excluding Electrically Initiated Explosive Devices); 2014.
- D. ASTM D4674 Standard Practice for Accelerated Testing for Color Stability of Plastics Exposed to Indoor Office Environments; 2002a (*Reapproved 2010*).
- E. CAL TITLE 24 P6 California Code of Regulations, Title 24, Part 6 (California Energy Code); 2013.
- F. CSA C22.2 No. 223 Power Supplies with Extra-low-voltage Class 2 Outputs; 2015.
- G. IEC 60929 AC and/or DC-Supplied Electronic Control Gear for Tubular Fluorescent Lamps Performance Requirements; 2015.
- H. IEC 61000-4-2 Electromagnetic Compatibility (EMC) Part 4-2: Testing and Measurement Techniques Electrostatic Discharge Immunity Test; 2008.
- I. IEC 61347-2-3 Lamp Control Gear Part 2-3: Particular Requirements for A.C. and/or D.C. Supplied Electronic Control Gear for Fluorescent Lamps; 2011, with Amendments, 2016.
- J. IEEE 1789 Recommended Practice for Modulating Current in High-Brightness LEDs for Mitigating Health Risks to Viewers; 2015.
- K. IEEE C62.41.2 Recommended Practice on Characterization of Surges in Low-Voltage (1000 V and less) AC Power Circuits; 2002 (Cor 1, 2012).
- L. ISO 9001 Quality Management Systems-Requirements; 2008.
- M. NECA 1 Standard for Good Workmanship in Electrical Construction; 2015.
- N. NECA 130 Standard for Installing and Maintaining Wiring Devices; National Electrical Contractors Association; 2010.
- O. NEMA 410 Performance Testing for Lighting Controls and Switching Devices with Electronic Drivers and Discharge Ballasts; National Electrical Manufacturers Association; 2015.
- P. NEMA WD 1 General Color Requirements for Wiring Devices; National Electrical Manufacturers Association; *1999 (R 2015).*
- Q. NFPA 70 National Electrical Code; National Fire Protection Association; *Most Recent Edition Adopted by Authority Having Jurisdiction, Including All Applicable Amendments and Supplements.*
- R. UL 20 General-Use Snap Switches; Current Edition, Including All Revisions.

- S. UL 508 Industrial Control Equipment; Underwriters Laboratories Inc.; *Current Edition, Including All Revisions.*
- T. UL 924 Emergency Lighting and Power Equipment; *Current Edition, Including All Revisions.*
- U. UL 935 Fluorescent-Lamp Ballasts; Current Edition, Including All Revisions.
- V. UL 1310 Class 2 Power Units; Current Edition, Including All Revisions.
- W. UL 1472 Solid-State Dimming Controls; Current Edition, Including All Revisions.
- X. UL 1598C Light-Emitting Diode (LED) Retrofit Luminaire Conversion Kits; *Current Edition, Including All Revisions.*
- Y. UL 2043 Fire Test for Heat and Visible Smoke Release for Discrete Products and Their Accessories Installed in Air-Handling Spaces; *Current Edition, Including All Revisions*.
- Z. UL 8750 Light Emitting Diode (LED) Equipment for Use in Lighting Products; *Current Edition, Including All Revisions.*

1.04 ADMINISTRATIVE REQUIREMENTS

- A. Coordination:
 - 1. Coordinate the placement of sensors and wall controls with millwork, furniture, equipment, etc. installed under other sections or by others.
 - 2. Coordinate the placement of wall controls with actual installed door swings.
 - 3. Coordinate the placement of daylight sensors with windows, skylights, and luminaires to achieve optimum operation. Coordinate placement with ductwork, piping, equipment, or other potential obstructions to light level measurement installed under other sections or by others.
 - 4. Coordinate the work to provide luminaires and lamps compatible with the lighting controls to be installed.
 - 5. Notify Architect of any conflicts or deviations from the contract documents to obtain direction prior to proceeding with work.
- B. Sequencing:
 - 1. Do not install sensors and wall controls until final surface finishes<< and painting>> are complete.

1.05 SUBMITTALS

- A. See Section 01 3000 Administrative Requirements for submittal procedures.
- B. Design Documents: Where Lighting Control Manufacturer Sensor Layout and Tuning service is specified in Part 2 under "LIGHTING CONTROLS - GENERAL REQUIREMENTS", Lighting Control Manufacturer to provide plans indicating occupancy/vacancy and/or daylight sensor locations.
- C. Product Data: Include ratings, configurations, standard wiring diagrams, dimensions, colors, service condition requirements, and installed features.
 - 1. Occupancy/Vacancy Sensors: Include detailed basic motion detection coverage range diagrams.
 - 2. Wall Dimmers: Include derating information for ganged multiple devices.
- D. Samples:
 - 1. Wall Controls:
 - a. Show available color and finish selections.
 - 2. Sensors:
- E. Manufacturer's Installation Instructions: Include application conditions and limitations of use stipulated by product testing agency. Include instructions for storage, handling, protection, examination, preparation, and installation of product.

- F. System Performance-Verification Documentation; *Lutron LSC-SPV-DOC*: Include additional costs for manufacturer's enhanced documentation detailing start-up performance-verification procedures and functional tests performed along with test results.
- G. Title 24 Acceptance Testing Documentation: Submit Certification of Acceptance and associated documentation for lighting control acceptance testing performed in accordance with CAL TITLE 24 P6, as specified in Part 3 under "COMMISSIONING".
- H. Project Record Documents: Record actual installed locations and settings for lighting control system components.
- I. Operation and Maintenance Data: Include detailed information on lighting control system operation, equipment programming and setup, replacement parts, and recommended maintenance procedures and intervals.
- J. Warranty: Submit sample of manufacturer's Warranty or Enhanced Warranty as specified in Part 1 under "WARRANTY". Submit documentation of final executed warranty completed in Owner's name and registered with manufacturer.

1.06 QUALITY ASSURANCE

- A. Conform to requirements of NFPA 70.
- B. Maintain at the project site a copy of each referenced document that prescribes execution requirements.
- C. Manufacturer Qualifications:
 - 1. Company with not less than five years of experience manufacturing lighting control products using wireless communication between devices.
 - 2. Registered to ISO 9001, including in-house engineering for product design activities.
 - 3. Provides factory direct technical support hotline available 24 hours per day, 7 days per week.
 - 4. Qualified to supply specified products and to honor claims against product presented in accordance with warranty.

1.07 DELIVERY, STORAGE, AND HANDLING

A. Store products in a clean, dry space in original manufacturer's packaging in accordance with manufacturer's written instructions until ready for installation.

1.08 FIELD CONDITIONS

- A. Maintain field conditions within manufacturer's required service conditions during and after installation.
 - 1. Basis of Design System Requirements *Lutron*, Unless Otherwise Indicated:
 - a. Ambient Temperature:
 - 1) Lighting Control System Components,.
 - b. Relative Humidity: Less than 90 percent, non-condensing.
 - c. Protect lighting controls from dust.

1.09 WARRANTY

- A. Manufacturer's Standard Warranty, Without Manufacturer Full-Scope Start-Up:
 - 1. Manufacturer Lighting Control System Components, Except Wireless Sensors, Ballasts/Drivers and Ballast Modules: One year 100 percent parts coverage, no manufacturer labor coverage.
 - 2. Wireless Sensors: Five years 100 percent parts coverage, no manufacturer labor coverage.
 - 3. Ballasts/Drivers and Ballast Modules: Three years 100 percent parts coverage, no manufacturer labor coverage.

- B. Manufacturer's Standard Warranty, With Manufacturer Full-Scope Start-Up; *Lutron Standard 2-Year Warranty; Lutron LSC-B2*:
 - 1. Manufacturer Lighting Control System Components, Except Lighting Management System Computer, Ballasts/Drivers and Ballast Modules:
 - a. First Two Years:
 - 1) 100 percent replacement parts coverage, 100 percent manufacturer labor coverage to troubleshoot and diagnose a lighting issue.
 - 2) First-available on-site or remote response time.
 - 3) Remote diagnostics for applicable systems.
 - b. Telephone Technical Support: Available 24 hours per day, 7 days per week, excluding manufacturer holidays.
 - 2. Lighting Management System Computer: One year 100 percent parts coverage, one year 100 percent manufacturer labor coverage.
 - 3. Ballasts/Drivers and Ballast Modules:
 - a. With Remote Full-Scope Start-Up: Three years 100 percent parts coverage, no manufacturer labor coverage.
 - b. With On-Site Full-Scope Start-Up: Five years 100 percent parts coverage, no manufacturer labor coverage.

PART 2 PRODUCTS

2.01 MANUFACTURERS

- A. Basis of Design Manufacturer: Lutron Electronics Company, Inc; Vive; www.lutron.com.
 - 1. Products by listed manufacturers are subject to compliance with specified requirements.
 - 2. Approved Manufacturers for Interior Lighting Controls:
 - a) Lutron (Basis of Design)
 - b) Creston
 - c)Douglas Lighting Control
- B. Substitutions:
 - 1. All proposed substitutions (clearly delineated as such) must be submitted in writing for approval by Engineer a minimum of 10 working days prior to the bid date and must be made available to all bidders. Proposed substitutes must be accompanied by a review of the specification noting compliance on a line-by-line basis.
 - 2. Any proposed substitutions to be reviewed by Engineer at Contractor's expense
 - 3. By using pre-approved substitutions, Contractor accepts responsibility and associated costs for all required modifications to related equipment and wiring. Provide complete engineered shop drawings (including power wiring) with deviations from the original design highlighted in an alternate color for review and approval by Architect prior to rough-in.
- C. Source Limitations: Furnish products produced by a single manufacturer and obtained from a single supplier.

2.02 LIGHTING CONTROLS - GENERAL REQUIREMENTS

- A. Sensor Layout and Tuning: Include additional costs for Lighting Control Manufacturer's Sensor Layout and Tuning service; *Lutron LSC-SENS-LT*:
 - 1. Lighting Control Manufacturer to take full responsibility for wired or wireless occupancy/vacancy and daylight sensor layout and performance for sensors provided by Lighting Control Manufacturer.

- 2. Lighting Control Manufacturer to analyze the reflected ceiling plans, via supplied electronic AutoCAD format, and design a detailed sensor layout that provides adequate occupancy sensor coverage and ensures occupancy and daylight sensor performance per agreed upon sequence of operations. Contractor to utilize the layouts for sensor placement.
- 3. During startup, Lighting Control Manufacturer to direct Contractor regarding sensor relocation, as required, should conditions require a deviation from locations specified in the drawings.
- 4. Lighting Control Manufacturer to provide up to two additional post-startup on-site service visits, within one calendar year from Date of Substantial Completion to fine-tune sensor calibration per the agreed upon sequence of operations.
- B. Provide products listed, classified, and labeled by Underwriter's Laboratories Inc. (UL) as suitable for the purpose indicated.
- C. Unless specifically indicated to be excluded, provide all required equipment, conduit, boxes, wiring, connectors, hardware, supports, accessories, programming, etc. as necessary for a complete operating system that provides the control intent indicated.
- D. Design lighting control equipment for 10 year operational life while operating continually at any temperature in an ambient temperature range of 32 degrees F (0 degrees C) to 104 degrees F (40 degrees C) and 90 percent non-condensing relative humidity.
- E. Electrostatic Discharge Tolerance: Design and test equipment to withstand electrostatic discharges without impairment when tested according to IEC 61000-4-2.
- F. Power Failure Recovery: When power is interrupted for periods up to 10 years and subsequently restored, lights to automatically return to same levels (dimmed setting, full on, or full off) as prior to power interruption.
- G. Wireless Devices:
 - 1. Wireless device family includes area or fixture level sensors, area or fixture level load controls for dimming or switching, and load controls that can be mounted in a wallbox, on a junction box, or at the fixture.
 - 2. Wireless devices including sensors, load controls, and wireless remotes or wall stations, can be set up using simple button press programming without needing any other equipment (e.g. central hub, processor, computer, or other smart device).
 - 3. Wireless hub adds the ability to set up the system using any smart device with a web browser (e.g. smartphone, tablet, PC, or laptop).
 - 4. System does not require a factory technician to set up or program the system.
 - 5. Capable of diagnosing system communications.
 - 6. Capable of having addresses automatically assigned to them.
 - 7. Receives signals from other wireless devices and provides feedback to user.
 - 8. Capable of determining which devices have been addressed.
 - 9. RF Range: 60 feet (18 m) line-of-sight or 30 feet (9 m) through typical construction materials between RF transmitting devices and compatible RF receiving devices.
 - 10. Electromagnetic Interference/Radio Frequency Interference (EMI/RFI) Limits: Comply with FCC requirements of CFR, Title 47, Part 15, for Class B application.
- H. Wireless Network:
 - 1. RF Frequency: 434 MHz; operate in FCC governed frequency spectrum for periodic operation; continuous transmission spectrum is not permitted.

- a. Wireless sensors, wireless wall stations and wireless load control devices do not operate in the noisy 2.4 GHz frequency band where high potential for RF interference exists.
- b. Wireless devices operate in an uncongested frequency band providing reliable operation.
- c. Fixed network architecture ensures all associated lights and load controls respond in a simultaneous and coordinated fashion from a button press, sensor signal, or command from the wireless hub (i.e. no popcorning).
- 2. Distributed Architecture: Local room devices communicate directly with each other. If the wireless hub is removed or damaged, local control, sensing, and operation continues to function without interruption.
- 3. Local room devices communicate directly with each other (and not through a central hub or processor) to ensure:
 - a. Reliability of system performance.
 - b. Fast response time to events in the space (e.g. button presses or sensor signals).
 - c. Independent operation in the event of the wireless hub being removed or damaged.
- I. Device Finishes:
 - 1. Wall Controls: shall be white, refer to plans for model numbers, unless otherwise indicated.
 - 2. Standard Colors: Comply with NEMA WD1 where applicable.
- J. Interface with existing building automation system; Lutron System and Network Integration Consultation; LSC-INT-VISIT.

2.03 WIRELESS SENSORS

- A. General Requirements:
 - 1. Operational life of 10 years without the need to replace batteries when installed per manufacturer's instructions.
 - 2. Communicates directly to compatible RF receiving devices through use of a radio frequency communications link.
 - 3. Does not require external power packs, power wiring, or communication wiring.
 - 4. Capable of being placed in test mode to verify correct operation from the face of the unit.
- B. Wireless Occupancy/Vacancy Sensors:
 - 1. General Requirements:
 - a. Provides a clearly visible method of indication to verify that motion is being detected during testing and that the unit is communicating to compatible RF receiving devices.
 - b. Utilize multiple segmented lens, with internal grooves to eliminate dust and residue build-up.
 - c. Sensing Mechanism: Passive infrared coupled with technology for sensing fine motions; *Lutron XCT Technology*. Signal processing technology detects fine-motion passive infrared (PIR) signals without the need to change the sensor's sensitivity threshold.
 - d. Provide optional, readily accessible, user-adjustable controls for timeout, automatic/manual-on, and sensitivity.

- e. Turns off lighting after reasonable and adjustable time delay once the last person to occupy the space vacates a room or area. Provide adjustable timeout settings of 1, 5, 15, and 30 minutes.
- f. Capable of turning dimmer's lighting load on to an optional locked preset level selectable by the user. Locked preset range to be selectable on the dimmer from 1 percent to 100 percent.
- g. Color: White.
- h. Provide all necessary mounting hardware and instructions for both temporary and permanent mounting.
- i. Provide temporary mounting means for drop ceilings to allow user to check proper performance and relocate as needed before permanently mounting sensor. Temporary mounting method to be design for easy, damage-free removal.
- j. Sensor lens to illuminate during test mode when motion is detected to allow installer to place sensor in ideal location and to verify coverage prior to permanent mounting.
- k. Ceiling-Mounted Sensors:
 - 1) Provide surface mounting bracket compatible with drywall, plaster, wood, concrete, and compressed fiber ceilings.
 - 2) Provide recessed mounting bracket compatible with drywall and compressed fiber ceilings.
- I. Wall-Mounted Sensors: Provide wall or corner mounting brackets compatible with drywall and plaster walls.
- 2. Wireless Combination Occupancy/Vacancy Sensors: Refer to plans and below.
 - a. Ceiling-Mounted Sensors: Programmable to operate as an occupancy sensor (automatic-on and automatic-off), an occupancy sensor with low light feature (automatic-on when less than one footcandle of ambient light available and automatic-off), or a vacancy sensor (manual-on and automatic-off).
 - b. Wall-Mounted Sensors: Programmable to operate as an occupancy sensor (automatic-on and automatic-off), or a vacancy sensor (manual-on and automatic-off).
 - c. Product(s):
 - <<Type _____ >>Ceiling-Mounted Occupancy/Vacancy Sensor; << Lutron Radio Powr Savr Series, Model LFR2-OCR2B-P-WH; or Lutron Radio Powr Savr Series, Model ULFR2-OCR2B-P-WH (BAA-Buy American Act Compliant)>>: Coverage from 324 square feet (30.2 sq m) to 676 square feet (62.4 sq m) depending on ceiling height from 8 to 12 feet (2.4 to 3.7 m); 360 degree field of view.
 - 2) <<Type _____ >>Wall-Mounted Occupancy/Vacancy Sensor; << Lutron Radio Powr Savr Series, Model LFR2-OWLB-P-WH; or Lutron Radio Powr Savr Series, Model ULFR2-OWLB-P-WH (BAA-Buy American Act Compliant)>>: Minor motion coverage of 1500 square feet (139.4 sq m) and major motion coverage of 3000 square feet (278.7 sq m) with mounting height of 6 to 8 feet (1.8 to 2.4 m); 180 degree field of view.
 - 3) <<Type _____ >>Corner-Mounted Occupancy/Vacancy Sensor; << Lutron Radio Powr Savr Series, Model LFR2-OKLB-P-WH; or Lutron

Radio Powr Savr Series, Model ULFR2-OKLB-P-WH (BAA-Buy American Act Compliant)>>: Minor motion coverage of 1225 square feet (113.8 sq m) and major motion coverage of 2500 square feet (232.3 sq m) with mounting height of 6 to 8 feet (1.8 to 2.4 m); 90 degree field of view.

- 4) <<Type _____ ->>Hallway Occupancy/Vacancy Sensor; << Lutron Radio Powr Savr Series, Model LFR2-OHLB-P-WH; or Lutron Radio Powr Savr Series, Model ULFR2-OHLB-P-WH (BAA-Buy American Act Compliant)>>: Major motion coverage of up to 150 feet (45.7 m) with mounting height of 6 to 8 feet (1.8 to 2.4 m); narrow field of view.
- 3. Wireless Vacancy-Only Sensors:
 - a. Operates only as a vacancy sensor (manual-on and automatic-off) Refer to plans and below.
 - b. Product(s):
 - <<Type ______- ->>Ceiling-Mounted Vacancy-Only Sensor; << Lutron Radio Powr Savr Series, Model LFR2-VCR2B-P-WH; or Lutron Radio Powr Savr Series, Model ULFR2-VCR2B-P-WH (BAA-Buy American Act Compliant)>>: Coverage from 324 square feet (30.2 sq m) to 676 square feet (62.4 sq m) depending on ceiling height from 8 to 12 feet (2.4 to 3.7 m); 360 degree field of view.
 - <<Type ______- ->>Wall-Mounted Vacancy-Only Sensor; << Lutron Radio Powr Savr Series, Model LFR2-VWLB-P-WH; or Lutron Radio Powr Savr Series, Model ULFR2-VWLB-P-WH (BAA-Buy American Act Compliant)>>: Minor motion coverage of 1500 square feet (139.4 sq m) and major motion coverage of 3000 square feet (278.7 sq m) with mounting height of 6 to 8 feet (1.8 to 2.4 m); 180 degree field of view.
 - <<Type _____ >>Corner-Mounted Vacancy-Only Sensor; << Lutron Radio Powr Savr Series, Model LFR2-VKLB-P-WH; or Lutron Radio Powr Savr Series, Model ULFR2-VKLB-P-WH (BAA-Buy American Act Compliant)>>: Minor motion coverage of 1225 square feet (113.8 sq m) and major motion coverage of 2500 square feet (232.3 sq m) with mounting height of 6 to 8 feet (1.8 to 2.4 m); 90 degree field of view.
 - 4) <<Type _____ ->>Hallway Vacancy-Only Sensor; << Lutron Radio Powr Savr Series, Model LFR2-VHLB-P-WH; or Lutron Radio Powr Savr Series, Model ULFR2-VHLB-P-WH (BAA-Buy American Act Compliant)>>: Major motion coverage of up to 150 feet (45.7 m) with mounting height of 6 to 8 feet (1.8 to 2.4 m); narrow field of view.

2.04 LOAD CONTROL MODULES

- A. Provide wireless load control modules as indicated or as required to control the loads as indicated.
- B. Junction Box-Mounted Modules:
 - 1. Plenum rated.
 - 2. 0-10 V Dimming Modules:
 - a. Product(s):
 - 8 A dimming module with 0-10V control, without emergency mode; << Lutron PowPak Dimming Module Model RMJS-8T-DV-B; or Lutron

PowPak Dimming Module Model URMJS-8T-DV-B (BAA-Buy American Act Compliant)>>.

- 2) 8 A dimming module with 0-10V control, with emergency mode; Lutron PowPak Dimming Module Model RMJS-8T-DV-B-EM.
- b. Communicates via radio frequency with up to ten compatible occupancy/vacancy sensors, ten wireless control stations, and one daylight sensor.
- c. Single low voltage dimming module with Class 1 or Class 2 isolated 0-10V output signal conforming to IEC 60929 Annex E.2; source or sink automatically configures.
- d. Selectable minimum light level.
- e. Configurable high- and low-end trim.
- f. Relay: Rated for 0-10 V ballasts, LED drivers, or fixtures that conform with NEMA 410.
- g. Dimming Modules with Emergency Mode:
 - Operation With *Lutron Vive* Wireless Hub: Upon loss of power, dimming module enters and remains in emergency mode as long as wireless hub is de-energized; upon restoration of power to wireless hub, dimming module returns to normal mode and lights automatically return to same levels (dimmed setting, full on, or full off) as prior to power interruption.
 - 2) Operation Without *Lutron Vive* Wireless Hub: Upon loss of power, dimming module enters and remains in emergency mode for 90 minutes, during which time local unit buttons and wireless controls are disabled.
 - 3) UL 924 listed.
- 3. Relay Modules:
 - a. Product(s):
 - 16 A relay module, without emergency mode, without contact closure output; << Lutron PowPak Relay Module Model RMJS-16R-DV-B; or Lutron PowPak Relay Module Model URMJS-16R-DV-B (BAA-Buy American Act Compliant)>>.
 - 2) 16 A relay module, with emergency mode, without contact closure output; Lutron PowPak Relay Module Model RMJS-16R-DV-B-EM.
 - 16 A relay module, without emergency mode, with contact closure output; << Lutron PowPak Relay Module Model RMJS-16RCCO1-DV-B; or Lutron PowPak Relay Module Model URMJS-16RCCO1-DV-B (BAA-Buy American Act Compliant)>>.
 - 4) 5 A relay module, without emergency mode, without contact closure output; *Lutron PowPak Relay Module Model RMJS-5R-DV-B*.
 - 5) 5 A relay module, without emergency mode, with contact closure output; Lutron PowPak Relay Module Model RMJS-5RCC01-DV-B.
 - b. Communicates via radio frequency with up to ten compatible occupancy/vacancy sensors, ten wireless control stations, and one daylight sensor.
 - c. Relay:
 - 1) Rated Life of Relay: Typical of 1,000,000 cycles at fully rated 16 A for all lighting loads.

4.

- 2) Load switched in manner that prevents arcing at mechanical contacts when power is applied to and removed from load circuits.
- 3) Fully rated output continuous duty for inductive, capacitive, and resistive loads.
- d. Contact Closure Output:
 - 1) Single contact closure output with normally open and normally closed dry maintained contacts suitable for connection to third party equipment (e.g. building management system, HVAC system, etc.).
 - 2) Contact Ratings: Resistive load; 1 A at 0-24 VDC, 0.5 A at 0-24 VAC.
 - 3) Controlled by associated occupancy/vacancy sensors and wall controls.
- e. Relay Modules With Emergency Mode:
 - 1) Operation With *Lutron Vive* Wireless Hub: Upon loss of power, relay module enters and remains in emergency mode as long as wireless hub is de-energized; upon restoration of power to wireless hub, relay module returns to normal mode and lights automatically return to same levels (dimmed setting, full on, or full off) as prior to power interruption.
 - Operation Without *Lutron Vive* Wireless Hub: Upon loss of power, relay module enters and remains in emergency mode for 90 minutes, during which time local unit buttons and wireless controls are disabled.
 UL 924 listed.
- Contact Closure Output Modules:
 - a. Product: << Lutron PowPak CCO Module Model RMJS-CCO1-24-B; or Lutron PowPak CCO Module Model URMJS-CCO1-24-B (BAA-Buy American Act Compliant)>>.
 - b. Communicates via radio frequency with up to ten compatible occupancy/vacancy sensors, ten wireless control stations, and one daylight sensor.
 - c. Contact Closure Output:
 - 1) Single contact closure output with normally open and normally closed dry maintained contacts suitable for connection to third party equipment (e.g. building management system, HVAC system, etc.).
 - 2) Contact Ratings: Resistive load; 1 A at 0-24 VDC, 0.5 A at 0-24 VAC.
 - 3) Operation affected by associated occupancy/vacancy sensors and wall controls.

2.05 WIRELESS CONTROL STATIONS

- A. Product(s): Refer to plan and below.
 - <<Type _____ ->>2-Button Control; <<Lutron Pico Wireless Control Model PJ2-2B; or Lutron Pico Wireless Control Module UPJ2-2B (BAA-Buy American Act Compliant)>>.
 - a. Button Marking: <<Light (icons); As indicated on drawings; or >>.
 - 2. <<Type _____ >>2-Button Control with Night Light; *Lutron Pico Wireless Control Model PJN-2B*.
 - 3. <<Type _____ >>2-Button with Raise/Lower Control; <<Lutron Pico Wireless Control Model PJ2-2BRL; or Lutron Pico Wireless Control Module UPJ2-2BRL (BAA-Buy American Act Compliant)>>.

- a. Button Marking: <<Light (icons); As indicated on drawings; or >>.
- <<Type _____ ->>3-Button Control; <<Lutron Pico Wireless Control Model PJ2-3B; or Lutron Pico Wireless Control Module UPJ2-3B (BAA-Buy American Act Compliant)>>.
 - a. Button Marking: <<Light (icons); As indicated on drawings; or _____>>.
- <<Type _____ ->>3-Button with Raise/Lower Control; <<Lutron Pico Wireless Control Model PJ2-3BRL; or Lutron Pico Wireless Control Module UPJ2-3BRL (BAA-Buy American Act Compliant)>>.
 - a. Button Marking: <<Light (icons); As indicated on drawings; or >>.
- 6. <<Type _____ ->>3-Button with Raise/Lower Control and Night Light; *Lutron Pico Wireless Control Model PJN-3BRL*.
- 7. <<<Type _____ >>4-Button; <<Lutron Pico Wireless Control Model PJ2-4B; or Lutron Pico Wireless Control Module UPJ2-4B (BAA-Buy American Act Compliant)>>.
 - a. Button Marking: <<Zone controls (light); Scene keypads (light); 2-group controllers (lights); 4-group toggle; As indicated on drawings; or _____>>.
- 8. Single Pedestal; Lutron Pico Pedestal Model L-PED1.
- 9. Double Pedestal; Lutron Pico Pedestal Model L-PED2.
- 10. Triple Pedestal; Lutron Pico Pedestal Model L-PED3.
- 11. Quadruple Pedestal; Lutron Pico Pedestal Model L-PED4.
- 12. Screw Mounting Kit; Lutron Model PICO-SM-KIT.
- 13. Wallbox Adapter; Lutron Model PICO-WBX-ADAPT.
- B. Communicates directly to compatible RF receiving devices through use of a radio frequency communications link.
- C. Does not require external power packs, power or communication wiring.
- D. Allows for easy reprogramming without replacing unit.
- E. Button Programming:
 - 1. Single action.
 - 2. Toggle action.
- F. Includes LED to indicate button press or programming mode status.
- G. Mounting:
 - 1. Capable of being mounted with a table stand or directly to a wall under a faceplate.
 - 2. Faceplates: Provide concealed mounting hardware.
- H. Power: Battery-operated with minimum ten-year battery life (3-year battery life for night light models).
- I. Finish: White

2.06 WIRELESS HUBS

A. Product(s): Refer to plans for model type .

--CHOOSE ONE OF THE TWO HUB TYPES BELOW--

- 1. Wireless hub without BACnet; *Lutron Vive Hub*.
- 2. Wireless hub with BACnet; *Lutron Vive Premium Hub*.

- a. Flush-mount wireless hub; *Model HJS-2-FM*; supports up to 700 total paired devices.
- b. Surface-mount wireless hub; *Model HJS-2-SM*; supports up to 700 total paired devices.
- B. Integrated multicolor LED provides feedback on what mode the hub is in for simple identification and diagnosis.
- C. Integrated processor and web server allows hub to set up and operate the system without any external connections to outside processors, servers, or the internet.
- D. Utilizes Ethernet connection for:
 - 1. Networking up to 64 hubs together to create a larger system.
 - 2. Integration with Building Management System (BMS) via native BACnet; does not require interface (*Lutron Vive Premium* wireless hub with BACnet only).
 - 3. Remote connectivity capabilities, including maintaining system date/time and receiving periodic firmware updates (requires internet connection).
- E. A single hub or network of hubs can operate on either a dedicated lighting control only network or can be integrated with an existing building network as a VLAN.
- F. Communicates directly to compatible *Lutron Vive* RF devices through use *Lutron Clear Connect* radio frequency communications link; does not require communication wiring; RF range of 71 feet (23 m) through walls to cover an area of 15836 square feet (1471 sq m) (device and hub must be on the same floor).
- G. Communicates directly to mobile device (smartphone or tablet) or computer using built-in Wi-Fi, 2.4 GHz 802.11b/g; wireless range of 71 feet (23 m) through walls (device and hub must be on the same floor).
 - 1. Does not require external Wi-Fi router for connecting to the hub.
- H. Allows for system setup, control, and monitoring from mobile device or computer using *Vive* web-based software:
 - 1. Supports paired devices up to maximum number indicated including compatible wireless sensors, wireless control stations, and wireless load devices.
 - 2. Allows for timeclock scheduling of events, both time of day and astronomic (sunrise and sunset).
 - a. Timeclock is integrated into the unit and does not require a constant internet connection.
 - b. Retains time and programming information after a power loss.
 - c. 365-day schedulable timeclock allows for:
 - 1) Scheduling of events years in advance.
 - 2) Setting of recurring events with exceptions on holidays.
 - d. Time clock events can be scheduled to:
 - 1) Send lights to a desired level and select the fade rate desired to reach that level.
 - 2) Adjust level lights go to when occupied.
 - 3) Adjust level lights go to when unoccupied.
 - 4) Enable/disable occupancy.
 - 5) Adjust timeout of sensors (requires *Model FC-SENSOR* wired fixture sensor or *Model DFCSJ-OEM-OCC* wireless fixture control dongle with integral sensing capabilities).

- 6) Control individual devices, areas, or groups of areas. When connected to *Vive Vue* server, only areas or groups of areas can be controlled with timeclock events.
- 3. Allows for control, monitoring, and adjustment from anywhere in the world (*Lutron Vive* wireless hub internet connection required).
- 4. Uses RF signal strength detection to find nearby devices for quick association and programming without having to climb ladders.
 - a. Association and setup does not require a factory technician to perform.
- 5. System using *Lutron Vive* wireless hub(s) can operate with or without connection to the internet.
- 6. Supports energy reporting.
 - a. Reports measured energy data for *PowPak* fixture control modules at accuracy of plus/minus 2 percent or 0.5 W (whichever is higher).
 - b. Reports calculated energy data for *PowPak* junction box mounted modules at accuracy of 10 percent.
 - c. Reports measured energy for *DFCSJ Series* wireless fixture control dongle when paired with driver that supports measured power (measurement accuracy defined by driver specification) or reports calculated power if driver does not have measurement capabilities.
- 7. Supports automatic demand response for load shedding via:
 - a. Local contact closure without need for separate interface.
 - b. OpenADR® 2.0b compliant utility command.
 - c. BACnet (*Lutron Vive Premium* wireless hub with BACnet only).
- 8. Support automatic generation of alerts in *Lutron Vive* web-based application for designated events/triggers, including:
 - a. Low-battery condition in battery-operated sensors and controls; alert cleared when battery is replaced.
 - b. Missing device (e.g., control or sensor); alert cleared when device is detected by system.
- 9. Wireless hub can be firmware upgraded to provide new software features and system updates.
 - a. Firmware update can be done either locally using a wired Ethernet connection or Wi-Fi connection, or remotely if the wireless hub is connected to the internet.
- I. *Lutron Vive* Web-Based Application:
 - 1. Accessibility and Platform Support:
 - a. Web-based; runs on most HTML5 compatible browsers (including Safari and Chrome).
 - b. Supports multiple platforms and devices; runs from a tablet, desktop, laptop, or smartphone.
 - c. User interface supports multi-touch gestures such as pinch to zoom, drag to pan, etc.
 - d. Utilizes HTTPS (industry-standard certificate-based encryption and authentication for security).
 - e. Multi-level Password Protected Access: Individual password protection on both the integrated Wi-Fi network and web-based software.
 - f. WPA2 security for Wi-Fi communication with wireless hub.

ISSUE FOR BIDDING AND CONSTRUCTION 02/12/2021

e.

- 2. System Navigation and Status Reporting:
 - a. Area Tree View: Easy navigation by area name to view status and make programing adjustments through the software.
 - b. Area and device names can be changed in real time.
- 3. Setup app available for iOS and Android that allows for:
 - a. Job registration to extend product warranty.
 - b. Management of setup for multiple projects in different locations.
 - c. Creation of handoff documents that are sent directly to a facility manager via email once setup is complete.
 - d. Backup of *Vive* wireless hub database to *Lutron* cloud for hub replacement.
 - Access to native help and instructions to assist user with *Vive* system setup.
- J. BACnet Integration (*Lutron Vive Premium* wireless hub with BACnet only):
 - 1. Provide ability to communicate by means of native BACnet IP communication (does not require interface) to lighting control system from a user-supplied 10BASE-T or 100BASE-T Ethernet network.
 - 2. Requires only one network connection per hub.
 - 3. BACnet Integrator Capabilities:
 - a. The BACnet integrator can command:
 - 1) Area light output.
 - 2) Area load shed level.
 - 3) Area load shed enable/disable.
 - 4) Enable/Disable:
 - (a) Area occupancy sensors.
 - (b) Area daylighting.
 - 5) Daylighting level.
 - 6) Area occupied and unoccupied level
 - 7) Occupancy sensor timeouts (for fixture sensors).
 - b. The BACnet integrator can monitor:
 - 1) Area on/off status.
 - 2) Area occupancy status.
 - 3) Area load shed status.
 - 4) Area instantaneous energy usage and maximum potential power usage.
 - 5) Enable/Disable:
 - (a) Area occupancy sensors.
 - (b) Daylighting.
 - (c) Timeclocks.
 - 6) Daylighting level.
 - 7) Light levels from photo sensors.
 - 8) Area occupied and unoccupied level.
 - 9) Occupancy sensor timeouts.
- K. API Integration:
 - 1. Support communication, without requiring interface, between lighting control system and third-party systems via RESTful API.
 - 2. Requires one network connection per wireless hub.
 - 3. API Integration Capabilities:
 - a. Control all zones or subset of zones.
 - 1) Set zones in designated area to specific level.

- 2) Raise/lower dimmable lights in designated area.
- b. Control individual zones.
- c. Subscribe to and Monitor:
 - 1) Area status changes (e.g., occupancy, light level, and instantaneous power).
 - 2) Individual zone changes in light level.
 - 3) Alerts (e.g., missing device and low battery).
- L. Scenes:
 - 1. Support programmable scenes to control individual devices, areas, or groups of areas on demand.
 - 2. Scenes may be activated via:
 - a. Contact closure input.
 - b. API integration.
 - c. Manual activation in app.
- M. Emergency Mode:
 - a. Support emergency mode to, when triggered, send lights to defined levels and lock out controls for *PowPak* load control modules equipped with emergency mode.
 - 2. Emergency mode may be activated via:
 - a. Contact closure input.
 - b. API integration.
 - c. Manual activation in app.
- N. Contact Closure Interface: Provide two contact closure inputs; accepts both momentary and maintained contact closures that can be used for automatic demand response.
- O. Rated for use in air-handling spaces as defined in UL 2043.
- P. Meets CAL TITLE 24 P6 requirements.

2.07 ACCESSORIES

- A. Emergency Lighting Interface:
 - 1. Product: *Lutron Model LUT-ELI*.
 - 2. Provides total system listing to UL 924 when used with lighting control system.
 - 3. Senses all three phases of building power.
 - 4. If power on any phase fails provides output to send lights controlled to defined levels. Lights to return to their previous intensities when normal power is restored.
 - Accepts contact closure input from fire alarm control panel.

2.08 SOURCE QUALITY CONTROL

A. Factory Testing; *Lutron Standard Factory Testing*:

- 1. Perform full-function factory testing on all completed assemblies. Statistical sampling is not acceptable.
- 2. Perform full-function factory testing on 100 percent of all ballasts and LED drivers.
- 3. Perform factory burn-in of 100 percent of all ballasts at 104 degrees F (40 degrees C).

PART 3 EXECUTION

5.

3.01 EXAMINATION

- A. Verify that field measurements are as shown on the drawings.
- B. Verify that ratings and configurations of system components are consistent with the indicated requirements.
- C. Verify that mounting surfaces are ready to receive system components.
- D. Verify that conditions are satisfactory for installation prior to starting work.

3.02 PREPARATION

- A. System and Network Integration Consultation; *Lutron LSC-INT-VISIT*: Include additional costs for Lighting Control Manufacturer to conduct meeting with facility representative and other related equipment manufacturers to discuss equipment and integration procedures.
 - 1. Coordinate scheduling of visit with Lighting Control Manufacturer. Manufacturer recommends that this visit be scheduled early in construction phase, after system purchase but prior to system installation.

3.03 INSTALLATION

- A. Perform work in a neat and workmanlike manner in accordance with NECA 1 and, where applicable, NECA 130.
- B. Install products in accordance with manufacturer's instructions.
- C. Sensor Locations:
 - Where Lighting Control Manufacturer Sensor Layout and Tuning service is specified in Part 2 under "LIGHTING CONTROLS - GENERAL REQUIREMENTS", locate sensors in accordance with layout provided by Lighting Control Manufacturer. Lighting Control Manufacturer may direct Contractor regarding sensor relocation should conditions require a deviation from locations indicated. Where Lighting Control Manufacturer Sensor Layout and Tuning service is not specified, locate sensors in accordance with Drawings.
 - 2. Sensor locations indicated are diagrammatic. Within the design intent, reasonably minor adjustments to locations may be made in order to optimize coverage and avoid conflicts or problems affecting coverage, in accordance with manufacturer's recommendations.
- D. Ensure that daylight sensor placement minimizes sensor view of electric light sources. Locate ceiling-mounted and luminaire-mounted daylight sensors to avoid direct view of luminaires.
- E. Lamp Burn-In: Operate lamps at full output for prescribed period per manufacturer's recommendations prior to use with any dimming controls. Replace lamps that fail prematurely due to improper lamp burn-in.
- F. Lamp Lead Lengths: Do not exceed 3 feet (0.9 m) for T4 4-pin compact and T5 BIAX lamps and 7 feet (2.1 m) for T5, T5-HO, T8 U-bend, and T8 linear fluorescent lamps.
- G. LED Light Engine/Array Lead Length: Do not exceed 100 feet (31 m).
- H. Identify system components in accordance with Section 26 0553.

3.04 FIELD QUALITY CONTROL

- A. See Section *Quality Requirements*, for additional requirements.
- B. Manufacturer's Full-Scope Start-Up Service is required.
- C. Manufacturer's Programming Service:
 - 1. Product(s):
 - a. On-site programming, 8-hour block; *Lutron LSC-OS-PROG8-SP*.
 - 2. Include additional costs for manufacturer to perform on-site programming tasks for 8 hours.
 - 3. Furnish unit prices for each available programming time interval.
- D. Manufacturer's Full-Scope Start-Up Service: **Provide manufacturer's On-Site Full-Scope Start-Up Service**.
 - 1. On-Site Full-Scope Start-Up Service; *Lutron LSC-OS-SU-VIVE*: Manufacturer's authorized Service Representative to conduct site visit upon completion of lighting control system installation to perform system startup and verify proper operation:

- a. Where Lighting Control Manufacturer Sensor Layout and Tuning service is specified in Part 2 under "LIGHTING CONTROLS GENERAL REQUIREMENTS", authorized Service Representative to verify sensor locations, in accordance with layout provided by Lighting Control Manufacturer; Lighting Control Manufacturer may direct Contractor regarding sensor relocation should conditions require a deviation from locations indicated.
- b. Verify connection of power wiring and load circuits.
- c. Verify connection and location of controls.
- d. Energize wireless hubs.
- e. Associate occupancy/vacancy sensors, daylight sensors, wireless remotes, and wall stations to load control devices.
- f. Provide initial rough calibration of sensors; fine-tuning of sensors is responsibility of Contractor unless provided by Lighting Control Manufacturer as part of Sensor Layout and Tuning service where specified in Part 2 under "LIGHTING CONTROLS - GENERAL REQUIREMENTS".
- g. Program timeclock schedules per approved sequence of operations.
- h. Configure load shed parameters per approved sequence of operations.
- i. Verify system operation control by control.
- j. Obtain sign-off on system functions.
- k. Train Owner's representative on system capabilities, operation, and maintenance, as specified in Part 3 under "Closeout Activities".
- E. Correct defective work, adjust for proper operation, and retest until entire system complies with contract documents.

3.05 ADJUSTING

- A. On-Site Scene and Level Tuning; *Lutron LSC-AF-VISIT*: Include additional costs for Lighting Control Manufacturer to visit site to conduct meeting with **Owner's** representative; to make required lighting adjustments to the system for conformance with original design intent.
- B. Sensor Fine-Tuning: Where Lighting Control Manufacturer Sensor Layout and Tuning service is specified in Part 2 under "LIGHTING CONTROLS - GENERAL REQUIREMENTS", Lighting Control Manufacturer to provide up to two additional poststartup on-site service visits for fine-tuning of sensor calibration. Where Lighting Control Manufacturer Sensor Layout and Tuning service is not specified, Contractor to provide finetuning of sensor calibration.

3.06 CLEANING

A. Clean exposed surfaces to remove dirt, paint, or other foreign material and restore to match original factory finish.

3.07 COMMISSIONING

A. Title 24 Acceptance Testing Service; *Lutron LSC-SPV-DOC-T24*: Include additional costs for Lighting Control Manufacturer to perform lighting control acceptance testing in accordance with CAL TITLE 24 P6. Submit required documentation.

3.08 CLOSEOUT ACTIVITIES

- A. See Section *Closeout Submittals*, for closeout submittals.
- B. See Section *Demonstration and Training*, for additional requirements.
- C. Demonstration:

- 1. Demonstrate proper operation of lighting control devices to **Engineer / Owner**, and correct deficiencies or make adjustments as directed.
- 2. On-Site Performance-Verification Walkthrough; *Lutron LSC-WALK*: Include additional costs for lighting control manufacturer to provide on-site demonstration of system functionality to **facility representative**.
- D. Training:
 - 1. Include services of manufacturer's certified service representative to perform on-site training of Owner's personnel on operation, adjustment, and maintenance of lighting control system as part of on-site system start-up services.
 - 2. Customer-Site Solution Training Visit; *Lutron LSC-TRAINING-SP*: Include additional costs for Lighting Control Manufacturer to provide **one** day(s) of additional on-site system training.
- E. On-Site Warranty Audit Visit; *Lutron LSC-WNTY-AUD*: Where Manufacturer On-Site Full-Scope Start-Up Service is not provided, include services of manufacturer to perform on-site verification that system meets manufacturer's requirements as necessary for validation of specified enhanced warranty.


3.09 MAINTENANCE


- A. See Section *Execution and Closeout Requirements*, for additional requirements relating to maintenance service.
- B. System Optimization Visit; *Lutron LSC-SYSOPT-SP*: Include additional costs for Lighting Control System Manufacturer to visit site **six months** after system start-up to evaluate system usage and discuss opportunities to make efficiency improvements that will fit with the current use of the facility.

3.10 PROTECTION

A. Protect installed products from subsequent construction operations.


END OF SECTION

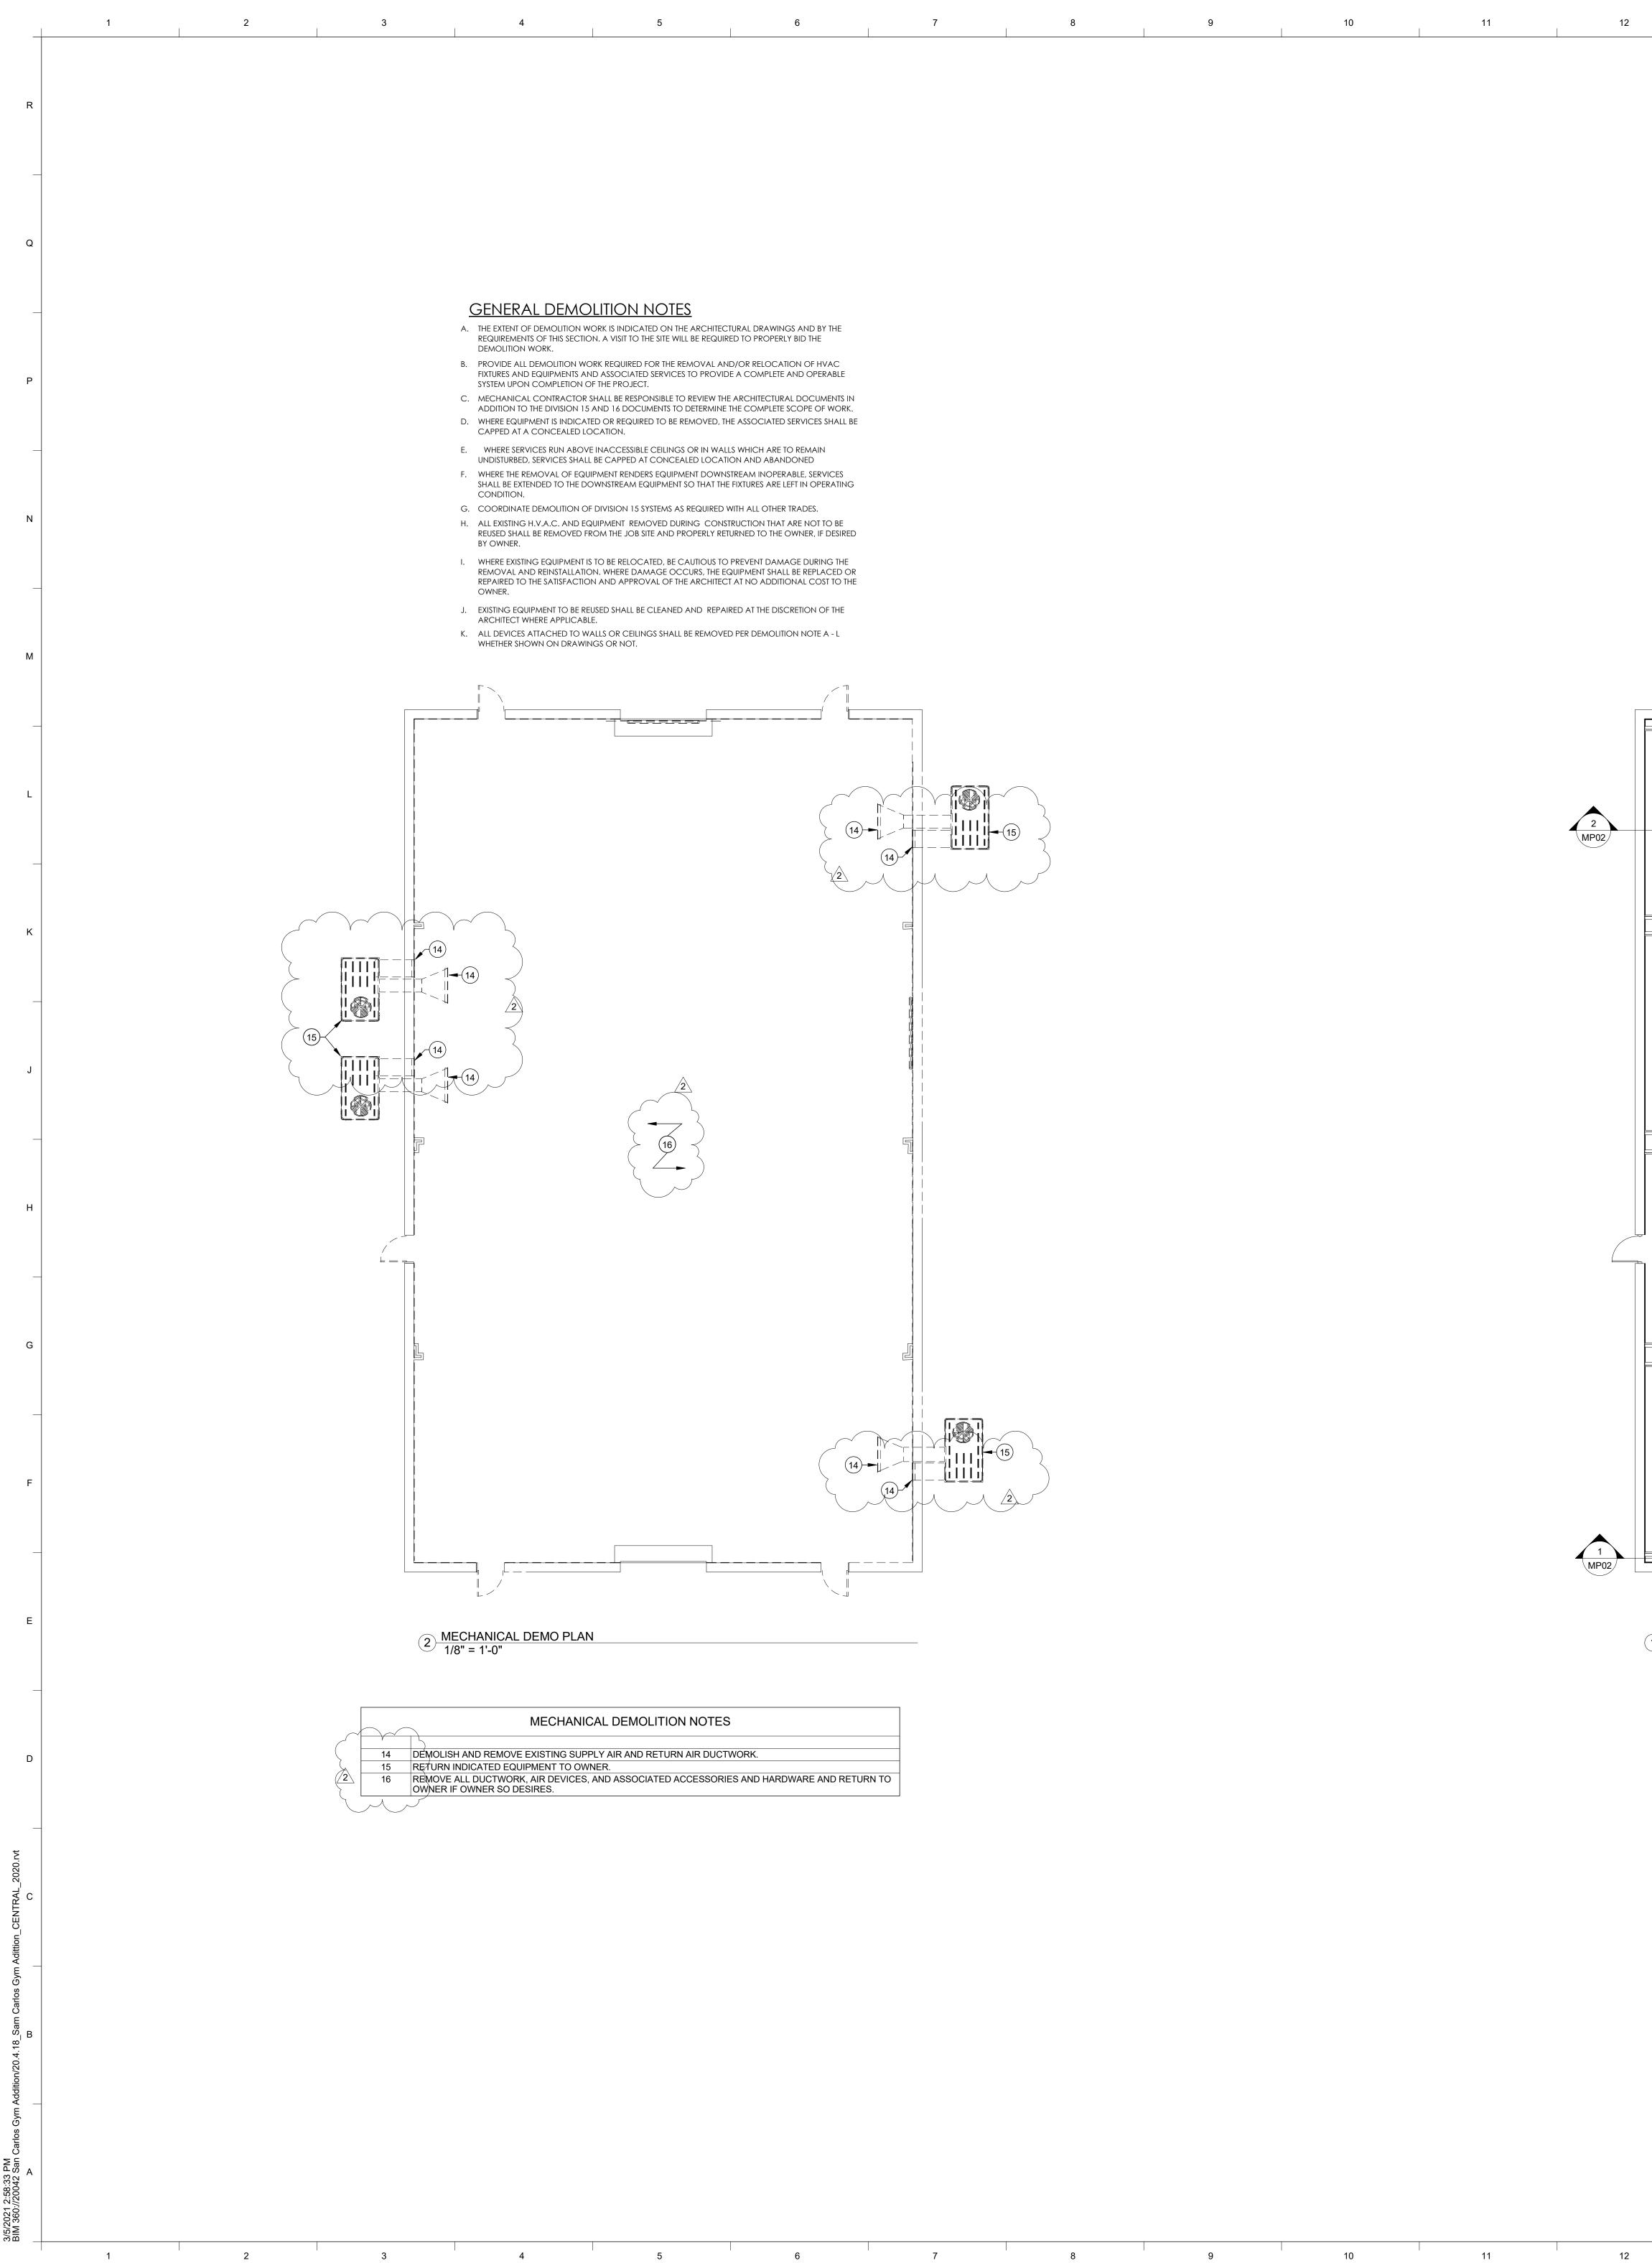


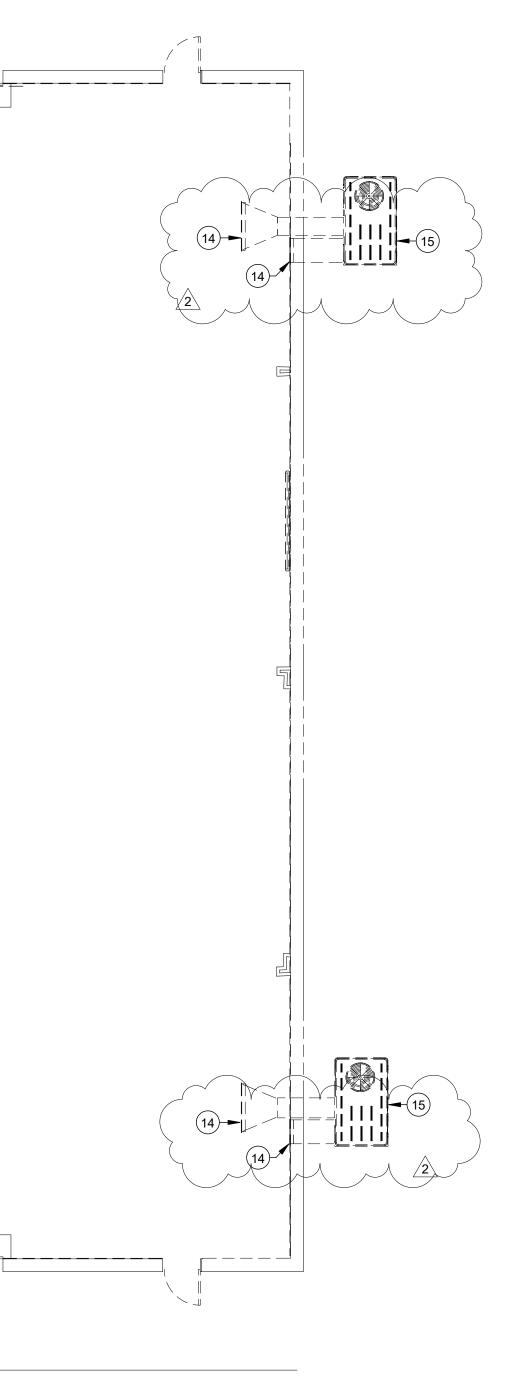

13

14

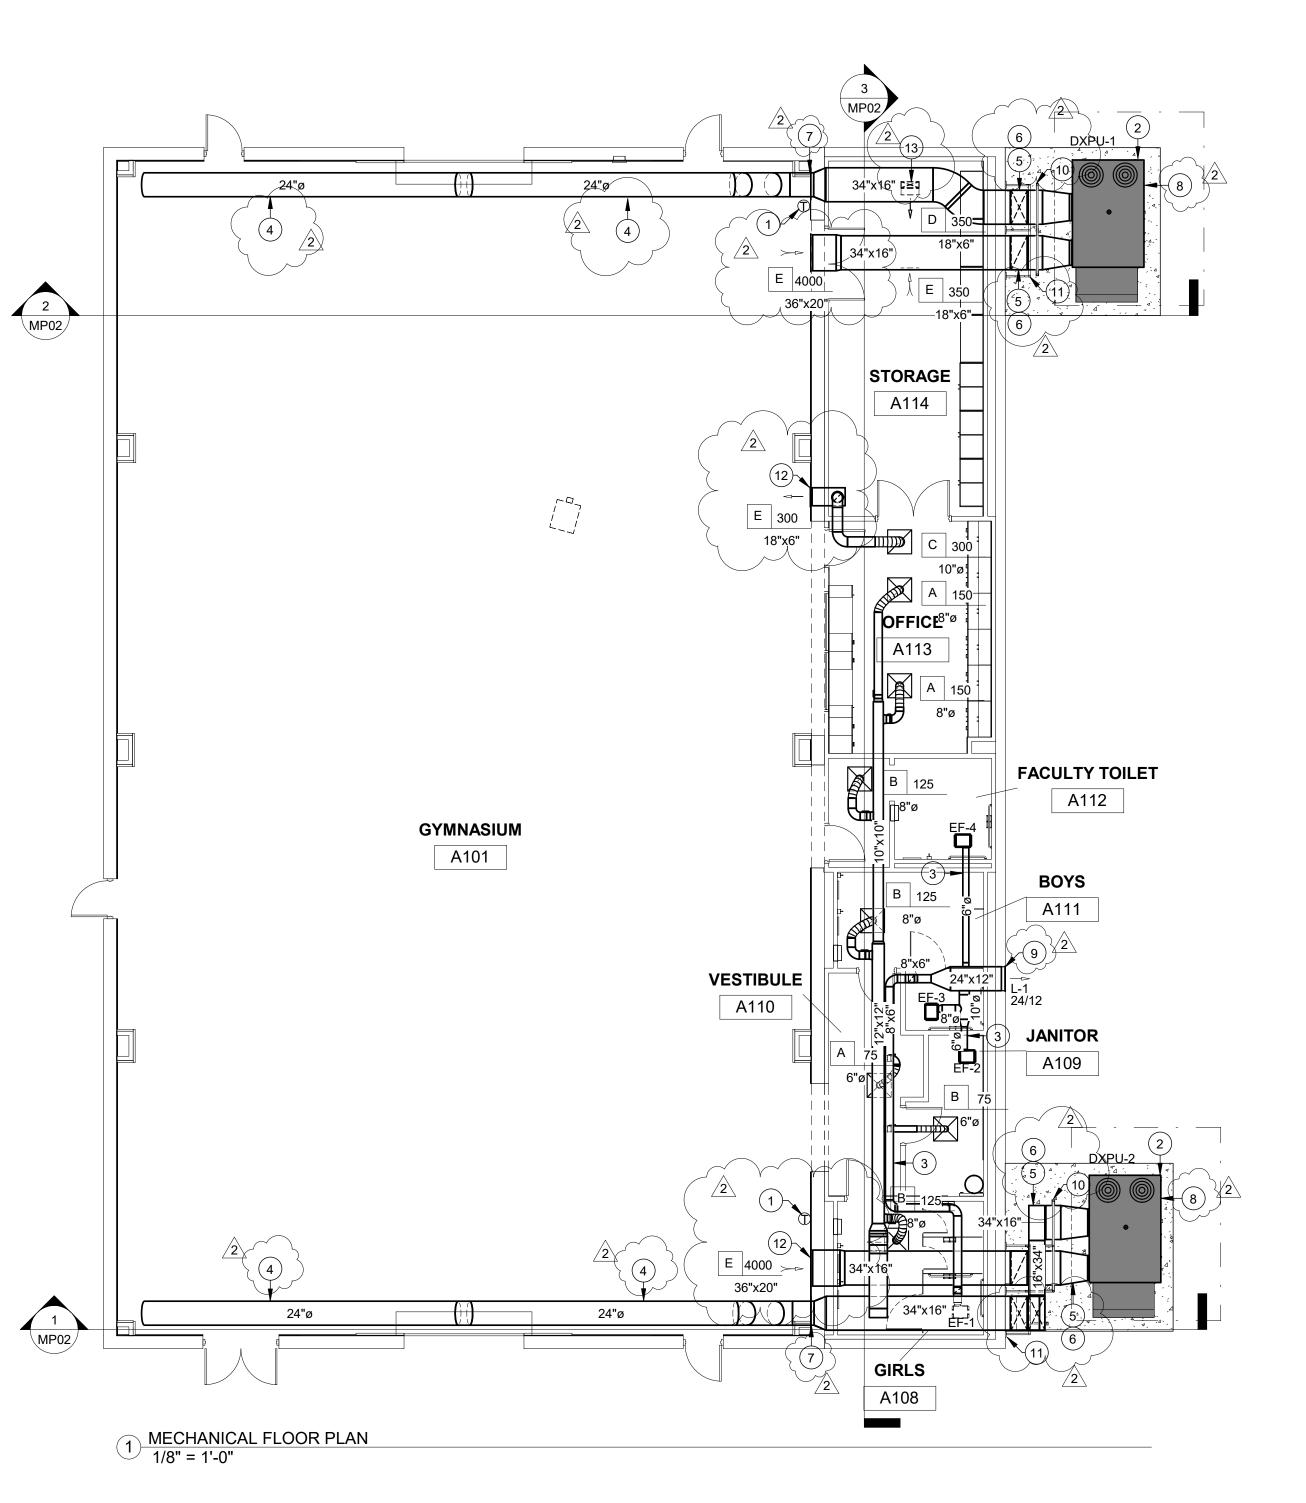

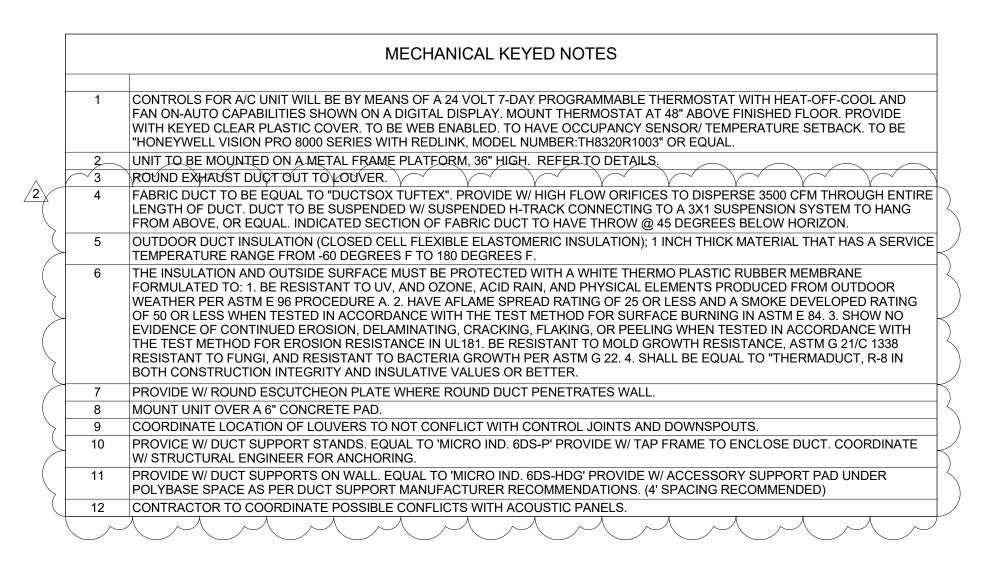



15

16

17




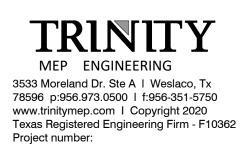

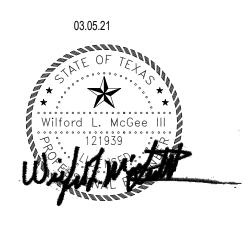



DISTRICT CONSOLIDATED INDEPENDENT SCHOOL 505 S. 83RD ST, EDINBURG TX 78539 EDINBURG

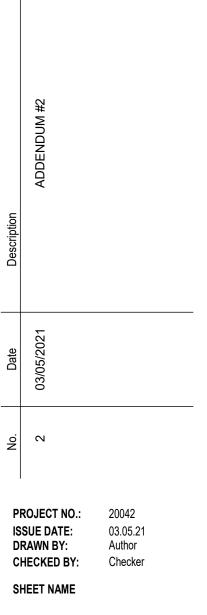


MECHANICAL FLOOR PLAN

Sheet Number

Project Status:

19


MP0

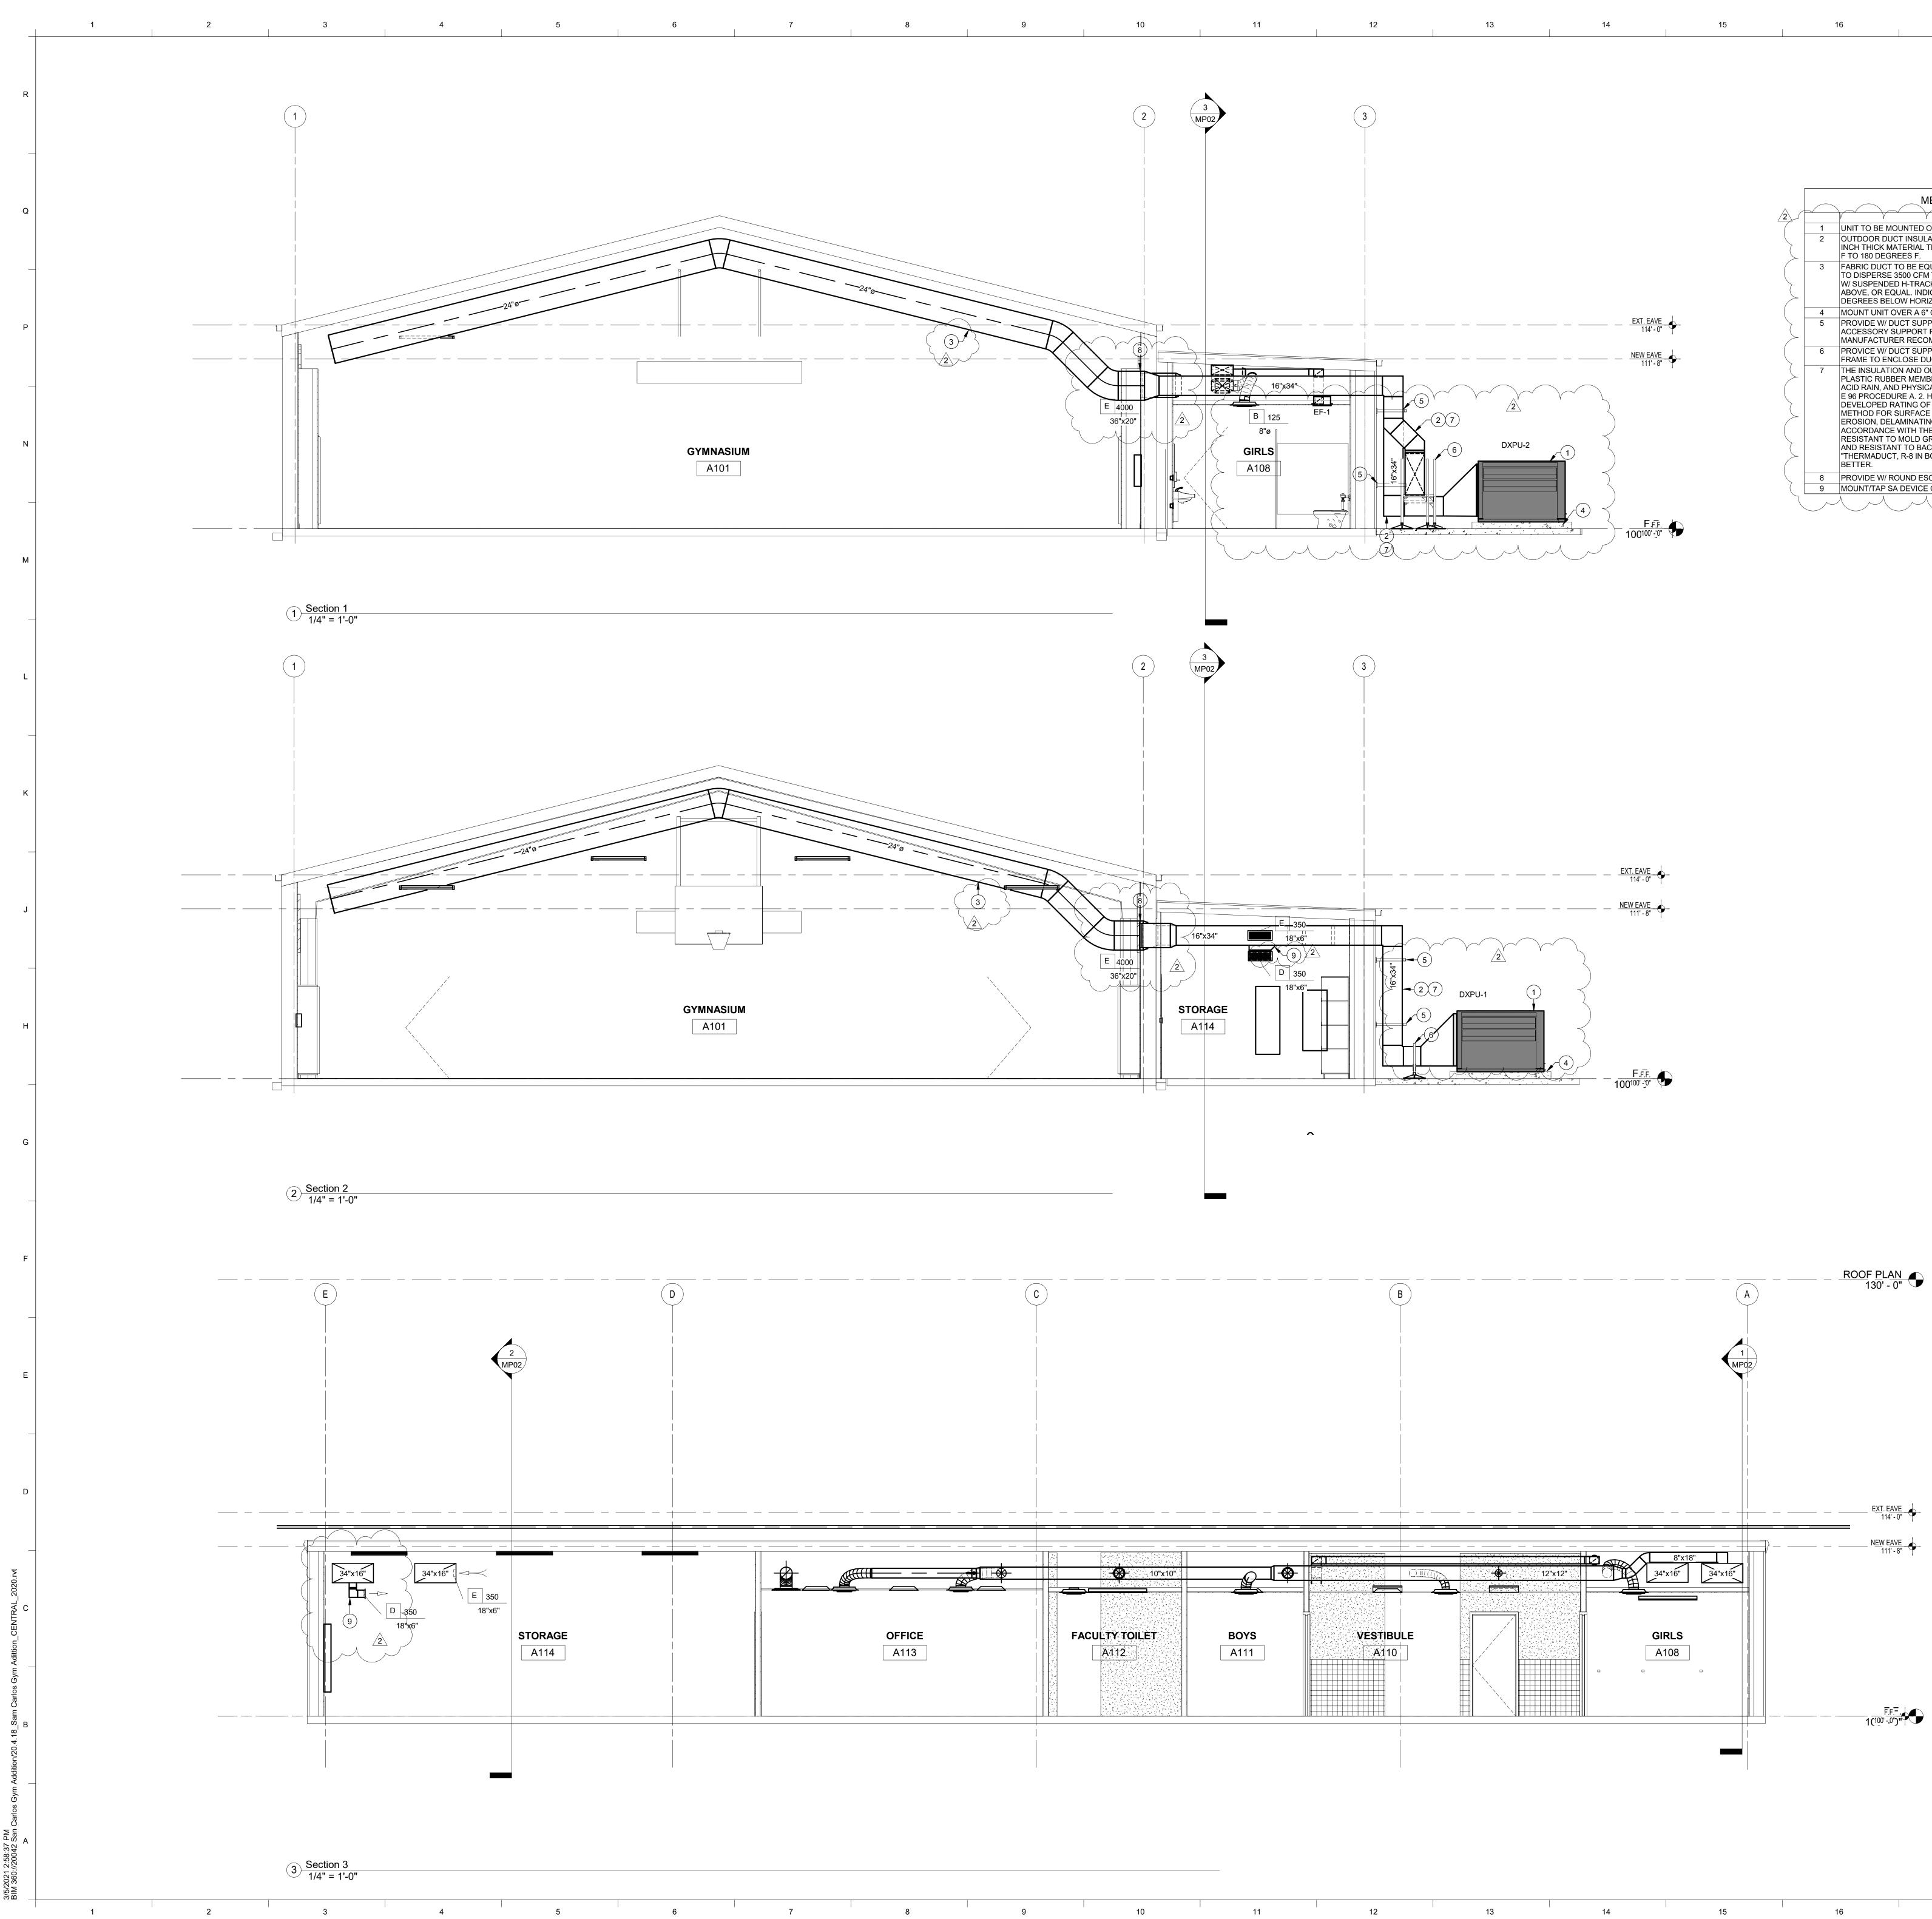

\frown		\frown	MEC	HANICA	L KEYED	NOTES	
~	γ	\rightarrow	\rightarrow	\rightarrow	\sim	\checkmark	<u> </u>
1	UNIT TO	D BE MOUI	NTED ON A	METAL FR	AME PLATE	ORM, 36" I	HIGH.
2	INCH TI		ERIAL THAT		D CELL FLE RVICE TEM		
3	TO DISI W/ SUS ABOVE	PERSE 350 PENDED H , OR EQUA	0 CFM THF I-TRACK CO	ROUGH EN ONNECTIN ED SECTIO	SOX TUFTE TIRE LENG ⁻ G TO A 3X1 DN OF FABF	TH OF DUC SUSPENS	T. DU
4	MOUNT	UNIT OVE	R A 6" CON	ICRETE PA	ND.		
5	ACCES	SORY SUF	PORT PAD	UNDER PO	L. EQUAL 7 DLYBASE S 8. (4' SPACII	PACE AS P	PER D
6					EQUAL TO ATE W/ STR		
7	PLASTIC ACID RA E 96 PR DEVELO METHO EROSIO ACCOR RESIST AND RE	C RUBBER AIN, AND F ROCEDURE OPED RAT D FOR SU DN, DELAW RDANCE W FANT TO M ESISTANT MADUCT, F	MEMBRAN PHYSICAL E E A. 2. HAVE ING OF 50 (RFACE BUI IINATING, C ITH THE TE OLD GROW TO BACTEF	NE FORMU ELEMENTS E AFLAME OR LESS W RNING IN A CRACKING, ST METHC /TH RESIS RIA GROW	ACE MUST E LATED TO: PRODUCEI SPREAD RA /HEN TESTI (STM E 84.3 FLAKING, (D FOR ERC TANCE, AS TH PER AST JCTION INT	1. BE RESI D FROM OL ATING OF 2 ED IN ACCO 3. SHOW NO DR PEELIN DSION RES FM G 21/C	STAN JTDO 5 OR ORDA O EVII G WH 6ISTAN 1338 F SHAL
8	_				ATE WHER		JUCT
9	MOUNT	T/TAP SA D	EVICE OFF	BOTTOM	OF SA DUC	Т.	

17

18

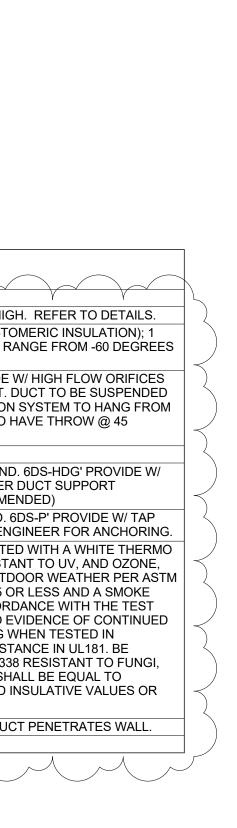


19




300 S. 8th Street, McAllen, Tx 78501 T 956-661-0400 | goero.com

TRINITY MEP ENGINEERING 3533 Moreland Dr. Ste A | Weslaco, Tx 78596 p:956.973.0500 | f:956-351-5750 www.trinitymep.com | Copyright 2020 Texas Registered Engineering Firm - F10362 Project number:

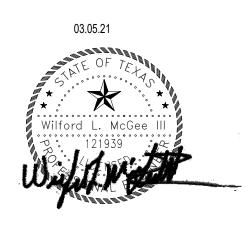



DISTRICT CONSOLIDATED INDEPENDENT SCHOOL 505 S. 83RD ST, EDINBURG TX 78539 RG

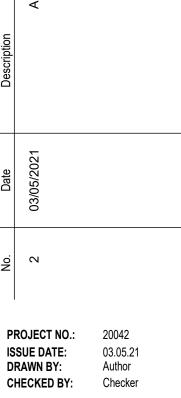

MECHANICAL SECTIONS

Sheet Number


SHEET NAME



Project Status:

100% CONSTRUCTION DOCUMENTS

18

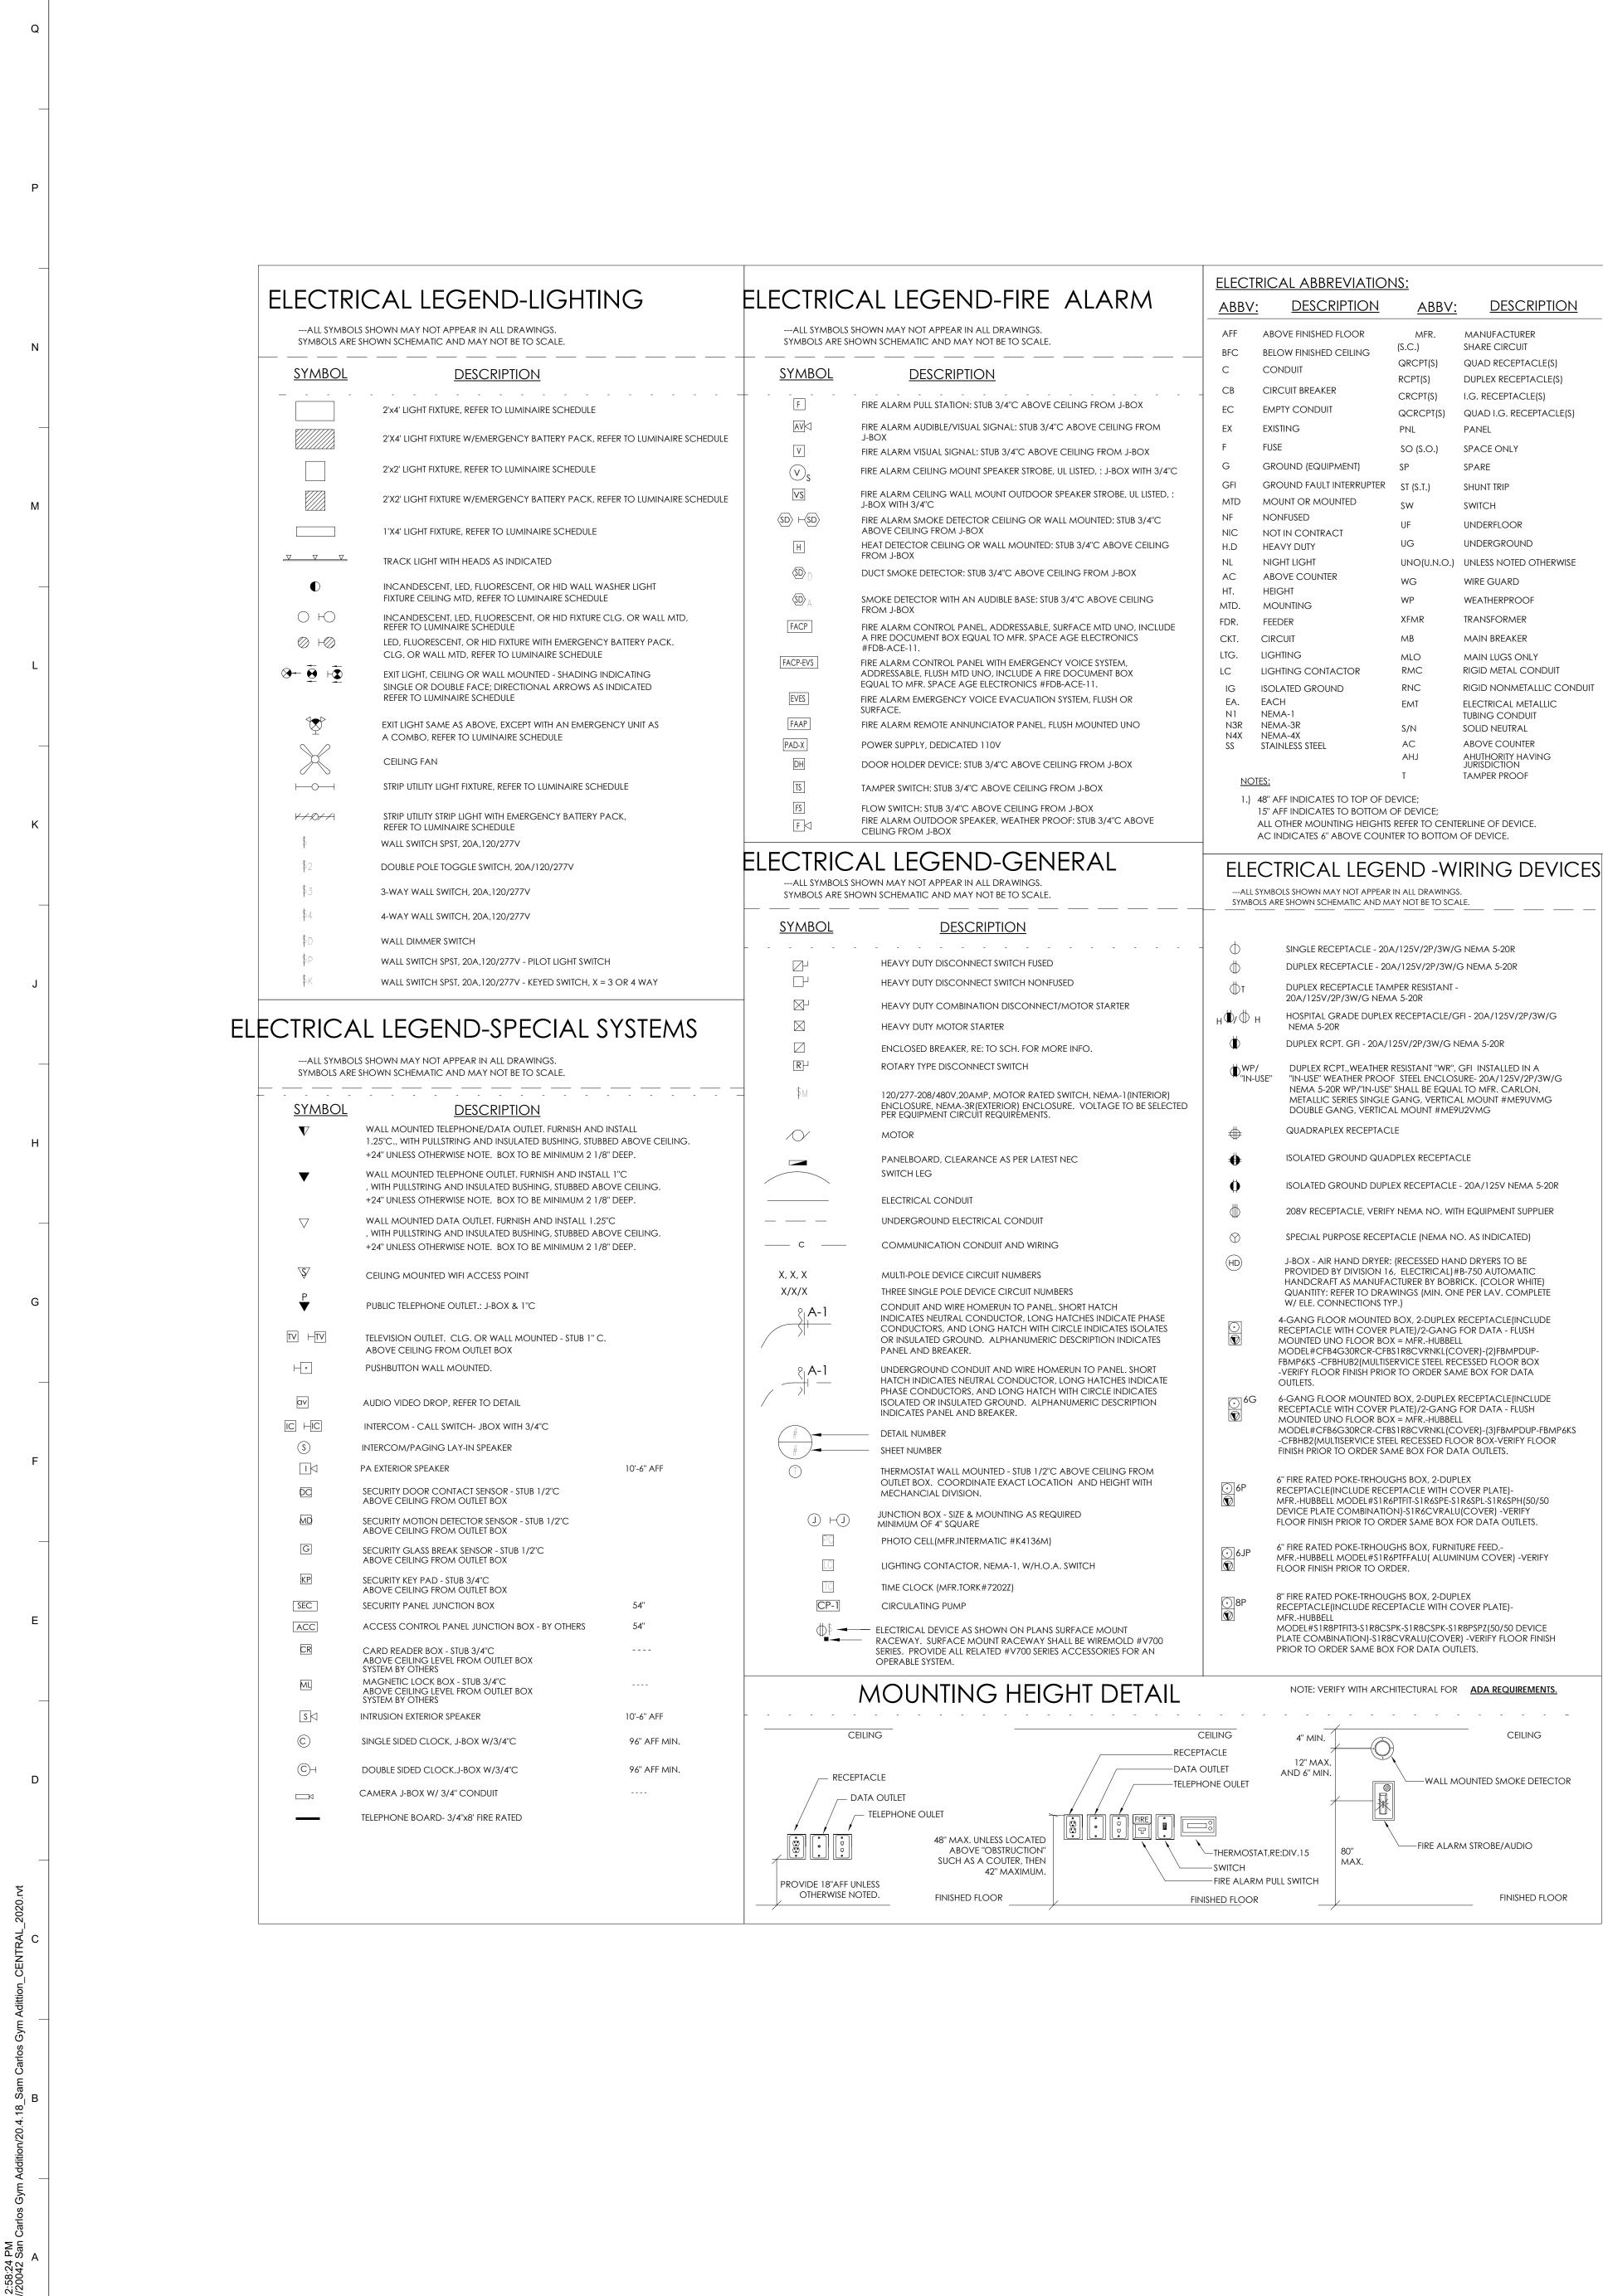

AL LEGEND-FIRE	ALARM

AL LEGLIND-TIKL ALARM	_
IOWN MAY NOT APPEAR IN ALL DRAWINGS. DWN SCHEMATIC AND MAY NOT BE TO SCALE.	
FIRE ALARM PULL STATION: STUB 3/4"C ABOVE CEILING FROM J-BOX	-
FIRE ALARM AUDIBLE/VISUAL SIGNAL: STUB 3/4"C ABOVE CEILING FROM	
J-BOX FIRE ALARM VISUAL SIGNAL: STUB 3/4"C ABOVE CEILING FROM J-BOX	
FIRE ALARM CEILING MOUNT SPEAKER STROBE, UL LISTED, : J-BOX WITH 3/4"C	
FIRE ALARM CEILING WALL MOUNT OUTDOOR SPEAKER STROBE, UL LISTED, : J-BOX WITH 3/4"C	
FIRE ALARM SMOKE DETECTOR CEILING OR WALL MOUNTED: STUB 3/4"C	
ABOVE CEILING FROM J-BOX HEAT DETECTOR CEILING OR WALL MOUNTED: STUB 3/4"C ABOVE CEILING	
FROM J-BOX DUCT SMOKE DETECTOR: STUB 3/4"C ABOVE CEILING FROM J-BOX	
SMOKE DETECTOR WITH AN AUDIBLE BASE: STUB 3/4"C ABOVE CEILING	
FROM J-BOX	
FIRE ALARM CONTROL PANEL, ADDRESSABLE, SURFACE MTD UNO, INCLUDE A FIRE DOCUMENT BOX EQUAL TO MFR. SPACE AGE ELECTRONICS #FDB-ACE-11.	
FIRE ALARM CONTROL PANEL WITH EMERGENCY VOICE SYSTEM, ADDRESSABLE, FLUSH MTD UNO, INCLUDE A FIRE DOCUMENT BOX EQUAL TO MFR. SPACE AGE ELECTRONICS #FDB-ACE-11.	
FIRE ALARM EMERGENCY VOICE EVACUATION SYSTEM, FLUSH OR SURFACE.	
FIRE ALARM REMOTE ANNUNCIATOR PANEL, FLUSH MOUNTED UNO	
POWER SUPPLY, DEDICATED 110V	
DOOR HOLDER DEVICE: STUB 3/4"C ABOVE CEILING FROM J-BOX	
TAMPER SWITCH: STUB 3/4"C ABOVE CEILING FROM J-BOX FLOW SWITCH: STUB 3/4"C ABOVE CEILING FROM J-BOX	
FILOW SWITCH, STOR 5/4 C ABOVE CEILING FROM 3-BOX FIRE ALARM OUTDOOR SPEAKER, WEATHER PROOF: STUB 3/4"C ABOVE CEILING FROM J-BOX	
AL LEGEND-GENERAL	_
IOWN MAY NOT APPEAR IN ALL DRAWINGS. DWN SCHEMATIC AND MAY NOT BE TO SCALE.	
HEAVY DUTY DISCONNECT SWITCH FUSED	_
HEAVY DUTY DISCONNECT SWITCH NONFUSED	
HEAVY DUTY COMBINATION DISCONNECT/MOTOR STARTER	
HEAVY DUTY MOTOR STARTER	
ENCLOSED BREAKER, RE: TO SCH. FOR MORE INFO.	
ROTARY TYPE DISCONNECT SWITCH	
120/277-208/480V,20AMP, MOTOR RATED SWITCH, NEMA-1 (INTERIOR) ENCLOSURE, NEMA-3R (EXTERIOR) ENCLOSURE. VOLTAGE TO BE SELECTED PER EQUIPMENT CIRCUIT REQUIREMENTS.	
MOTOR	
PANELBOARD, CLEARANCE AS PER LATEST NEC	
SWITCH LEG	
ELECTRICAL CONDUIT	
UNDERGROUND ELECTRICAL CONDUIT	
COMMUNICATION CONDUIT AND WIRING	
MULTI-POLE DEVICE CIRCUIT NUMBERS	
THREE SINGLE POLE DEVICE CIRCUIT NUMBERS CONDUIT AND WIRE HOMERUN TO PANEL, SHORT HATCH	
INDICATES NEUTRAL CONDUCTOR, LONG HATCHES INDICATE PHASE CONDUCTORS, AND LONG HATCH WITH CIRCLE INDICATES ISOLATES OR INSULATED GROUND. ALPHANUMERIC DESCRIPTION INDICATES	
UNDERGROUND CONDUIT AND WIRE HOMERUN TO PANEL. SHORT HATCH INDICATES NEUTRAL CONDUCTOR, LONG HATCHES INDICATE PHASE CONDUCTORS, AND LONG HATCH WITH CIRCLE INDICATES ISOLATED OR INSULATED GROUND. ALPHANUMERIC DESCRIPTION INDICATES PANEL AND BREAKER.	
— DETAIL NUMBER	
- SHEET NUMBER	
THERMOSTAT WALL MOUNTED - STUB 1/2"C ABOVE CEILING FROM OUTLET BOX. COORDINATE EXACT LOCATION AND HEIGHT WITH MECHANCIAL DIVISION.	
JUNCTION BOX - SIZE & MOUNTING AS REQUIRED MINIMUM OF 4" SQUARE	
PHOTO CELL(MFR.INTERMATIC #K4136M)	
LIGHTING CONTACTOR, NEMA-1, W/H.O.A. SWITCH	

MOUNTING HEIGHT DETAIL

LABBREVIATIONS:				
<u>DESCRIPTION</u>	<u>ABBV:</u>	<u>DESCRIPTION</u>		
E FINISHED FLOOR FINISHED CEILING UIT IT BREAKER CONDUIT G	MFR. (S.C.) QRCPT(S) RCPT(S) CRCPT(S) QCRCPT(S) PNL	MANUFACTURER SHARE CIRCUIT QUAD RECEPTACLE(S) DUPLEX RECEPTACLE(S) I.G. RECEPTACLE(S) QUAD I.G. RECEPTACLE(S) PANEL SPACE ONLY		
ND (EQUIPMENT) ND FAULT INTERRUPTER T OR MOUNTED JSED CONTRACT DUTY LIGHT COUNTER T TING CONTER T IG G CONTACTOR ED GROUND	SP ST (S.T.) SW UF UG UNO(U.N.O.) WG WP XFMR MB MLO RMC RMC RMC EMT S/N	SPARE SHUNT TRIP SWITCH UNDERFLOOR UNDERGROUND UNLESS NOTED OTHERWISE WIRE GUARD WEATHERPROOF TRANSFORMER MAIN BREAKER MAIN BREAKER MAIN LUGS ONLY RIGID MONMETALLIC CONDUIT ELECTRICAL METALLIC SOLID NEUTRAL		
4X ESS STEEL	AC AHJ T	ABOVE COUNTER AHUTHORITY HAVING JURISDICTION TAMPER PROOF		

1.	ALL SYMBOLS AND ABBREVIATIONS SHOWN ON THIS LEGEND APPEAR ON THIS SET OF DRAWINGS.
2.	USE DIRECTIONAL ARROW ON EXIT SIGNS AS REQUIRED.
3.	IEEE STANDARD C37.2-1991, ELECTRICAL POWER SYSTEM DEV NUMBERS.
4.	CONTRACTOR SHALL NOT INSTALL MORE THAN THREE CURRE CONDUCTORS IN A COMMON RACEWAY. IF CONTRACTOR GROUPING MULTIPLE CIRCUITS IN A SINGLE RACEWAY, THE C MUST SUBMIT ALL DERATING CALCULATIONS FOR THE PROPO INSTALLATION IN ACCORDANCE WITH NEC ARTICLE 310.15 (E APPROVAL PRIOR TO INSTALLATION. NON APPROVED INSTAL BE REMOVED AND REINSTALLED BY THE CONTRACTOR IN ACC

GENERAL ELECTRICAL NOTES

	THE NEC AT NO ADDITIONAL COST TO THE OWNER.
5.	THERE SHALL NOT BE MORE THAN THE EQUIVALENT OF THREE S (270 DEGREES TOTAL) BETWEEN PULL POINTS. WHERE THERE A THAN THREE QUARTER BENDS, CONTRACTOR SHALL PROVIDE AS SPECIFIED AND SIZED IN ACCORDANCE WITH NEC.
	COMPLY WITH NEC REQUIREMENTS FOR ELECTRICAL INSTALL

6. ELECTRICAL EQUIPMENT AND MATERIAL TO BE APPROVED, LISTED, LABELED, IDENTIFIED AND INSTALLED PER RECOGNIZED ELECTRICAL TESTING LABORATORY. ALL RECEPTACLES, SWITCHES AND JUNCTION BOXES SERVED BY EMERGENCY BRANCH CIRCUITS SHALL BE "RED" IN COLOR. COVERPLATES SHALL BE LABELED IN ACCORDANCE WITH SPECIFICATIONS TO INDICATE

PANELBOARD AND CIRCUIT NO. (IE: ET*LA-3).

Tag	Lamp	۱V		
A	LED (4800LM) (37W)	2		
AE	LED (4800LM) (37W)	2		
В	LED (3800LM) (29W)	2		
BE	LED (3800LM) (29W)	2		
С	LED (18000 LM) (133W)	2		
CE	LED (18000 LM) (133W)	2		
E2	LED 2	2		
F	LED (5500LM) (45W)	2		
FE	LED (5500LM) (45W)	2		
X1	INCLUDED	2		
AA (LED (3800LM) 37W	2		
	AL MANUFACTURER SHA AIT EQUAL MANUFACTU			
,	/IT LIGHT FIXTURES CU			
	RACTOR SHALL VERIFY			
	ION CONTRACTOR PRIC			
5.) ANCH	IOR BOLTS SHALL BE O	Fγ		

INDEX OF SHEETS ELEC				
Sheet Number	Sheet Name			
EG01	ELECTRICAL LEGEND			
ES1.1	ELECTRICAL SITE PLAN			
ELPD01	ELECTRICAL DEMO PLAN			
EL01	ELECTRICAL FLOOR PLAN			
ER01	ELECTRICAL RISER			
ED01	ELECTRICAL DETAILS			

360:

3/5/2 BIM

1

2 3 4

10

WN ON THIS LEGEND MAY NOT	
S AS REQUIRED.	
POWER SYSTEM DEVICE FUNCTION	ELECTRICAL: LIGHTING FUNCTIONAL TESTING / COMMISSIONING PLAN:
E THAN THREE CURRENT CARRYING Y. IF CONTRACTOR IS PLANNING ON GLE RACEWAY, THE CONTRCATOR DNS FOR THE PROPOSED	CONTRACTOR SHALL PERFORM THE TASK BELOW TO COMMISSION THE LIG CONTRACTOR SHALL SUBMIT A DOCUMENTATION DETAILING THE LIGHTING SETTING/CONDITION, ACTIONS PERFORMED AND FINAL SETTING CONDITIO DOCUMENTATION AT OR BEFORE SUBSTANTIAL COMPLETION TO FACILITAT CERTIFICATE OF OCCUPANCY.
EC ARTICLE 310.15 (B) (2) FOR IN APPROVED INSTALLATIONS WILL CONTRACTOR IN ACCORDANCE WITH IE OWNER.	A. ENSURE ALL LIGHTING FIXTURES FIXTURES HAVE LAMPS INSTALLED AND A B. TEST ALL EXIT SIGNS, EMERGENCY LIGHTING FIXTURES, AND EMERGENCY INTEGRAL TO FIXTURES. C. ENSURE ALL OCCUPANCY SENSORS HAVE BEEN INSTALLED AND ARE OF
UIVALENT OF THREE 90° BENDS NTS. WHERE THERE ARE MORE TOR SHALL PROVIDE PULL BOXES CE WITH NEC.	D. VERIFY ALL WALLBOX AND SCENE CONTROLLERS ARE INSTALLED AND C E. TEST EACH INDIVIDUAL DEVICE FOR OCCUPANCY SENSOR TYPES OS1, C CONTROL RELAY PANEL SYSTEM. F. TEST 10% OF ALL THE DEVICES FOR OCCUPANCY SENSOR TYPE: WSX-PDT G. VERIFY THE FOLLOWING:
ELECTRICAL INSTALLATIONS. ALL	1. ALL SENSORS ARE LOCATED AND AIMED PER THE MANUFACTURER'S RE 2. STATUS INDICATORS ON DEVICES ARE OPERATIONAL AND CORRECT. 3. DEVICES CONTROL LICHTING EXTURES AS INDICATED ON DRAWINGS

CONTRACTOR SHALL PERFORM THE TASK BELOW TO COMMISSION THE LIGHTING CONTROL SYSTEM. CONTRACTOR SHALL SUBMIT A DOCUMENTATION DETAILING THE LIGHTING CONTROL SYSTEM, SETTING/CONDITION, ACTIONS PERFORMED AND FINAL SETTING CONDITION. SUBMIT DOCUMENTATION AT OR BEFORE SUBSTANTIAL COMPLETION TO FACILITATE OBTAINING THE CERTIFICATE OF OCCUPANCY. A. ENSURE ALL LIGHTING FIXTURES FIXTURES HAVE LAMPS INSTALLED AND ARE FUNCTIONAL. B. TEST ALL EXIT SIGNS, EMERGENCY LIGHTING FIXTURES, AND EMERGENCY BALLASTS FURNISHED INTEGRAL TO FIXTURES. C. ENSURE ALL OCCUPANCY SENSORS HAVE BEEN INSTALLED AND ARE OPERATIONAL. D. VERIFY ALL WALLBOX AND SCENE CONTROLLERS ARE INSTALLED AND OPERATIONAL. E. TEST EACH INDIVIDUAL DEVICE FOR OCCUPANCY SENSOR TYPES OS1, OS2 AND TEST THE LIGHTING CONTROL RELAY PANEL SYSTEM. F. TEST 10% OF ALL THE DEVICES FOR OCCUPANCY SENSOR TYPE: WSX-PDT-SA. G. VERIFY THE FOLLOWING: 1. ALL SENSORS ARE LOCATED AND AIMED PER THE MANUFACTURER'S RECOMMENDATIONS. 2. STATUS INDICATORS ON DEVICES ARE OPERATIONAL AND CORRECT. 3. DEVICES CONTROL LIGHTING FIXTURES AS INDICATED ON DRAWINGS. 4. TIME DELAYS HAVE BEEN SET AS PER CODE AND PER OWNERS DIRECTIONS. 5. MOVEMENT IN ADJACENT AREAS AND/ CYCLING OF HVAC SYSTEMS DOES NOT FALSE TRIGGER SENSORS. 6. PHOTOCELL LOCATION AND AIMED PER MANUFACTURERS RECOMMENDATIONS.

7. PROGRAM INTERIOR RELAYS WITH A TIME FUNCTION ACCEPTABLE TO OWNER.

8. PROGRAM INTERIOR OVERRIDE SWITCH WITH A TIME FUNCTIONAL ACCEPTABLE BY OWNER.

	Light Fixture Schedule					
Voltage	Mounting	Description	Manufacturer	Model		
277V	RECESSED	2X4 LAY-IN LED FLUXPANEL WITH LENS AND LED DRIVER INCLUDE ALL NECESSARY MOUNTING ACCESSORIES.	DAY-BRITE	2FPZ48L840-4-DS-UNV-DIM		
277V	RECESSED	2X4 LAY-IN LED FLUXPANEL WITH LENS AND LED DRIVER INCLUDE ALL NECESSARY MOUNTING ACCESSORIES.	DAY-BRITE	2FPZ48L840-4-DS-UNV-DIM-BSL10LST		
277V	RECESSED	2X4 LAY-IN LED FLUXPANEL WITH LENS AND LED DRIVER INCLUDE ALL NECESSARY MOUNTING ACCESSORIES.	DAY-BRITE	2FPZ38L840-4-DS-UNV-DIM		
277V	RECESSED	2X4 LAY-IN LED FLUXPANEL WITH LENS AND LED DRIVER AND EMERGENCY BATTERY BACKUP INCLUDE ALL NECESSARY MOUNTING ACCESSORIES.	DAY-BRITE	2FPZ38L840-4-DS-UNV-DIM-BSL10LST		
277V	SURFACE	LED HIGHBAY SMART LUMINAIRE WITH MOTION/DAYLIGHT SENSOR	DAY-BRITE	FBY-18L-840-UNV-XX		
277V	SURFACE	LED HIGHBAY SMART LUMINAIRE WITH MOTION/DAYLIGHT SENSOR	DAY-BRITE	FBY-18L-840-UNV-XX-BSL10LST		
	SURFACE @ 8'-0"	ARCHITECTURAL DIE-CAST EMERGENCY LIGHTING	CHLORIDE	PLEMBZ-BAC		
277V	SURFACE	4' LED STRIP LIGHT	DAY-BRITE	FSS455L840-UNV-DIM		
277V	SURFACE	4' LED STRIP LIGHT WITH EMERGENCY BATTERY BACKUP	DAY-BRITE	FSS455L840-UNV-DIM-EMLED		
277V	SURFACE	THERMOPLASTIC EXIT/EMERGENCY UNIT WITH SELF-DIAGNOSTICS	CHLORIDE	VLTCR3R		
	SURFACE @10'-0"	WALL MOUNTED FIXTURE RATED FOR WET LOCATION. FIXTURE SHALL BE MOUNTED 10'-0" A.F.F. COORDINATE WITH ALL DISCIPLINES AND ARCHITECTURAL DOCUMENTS PRIOR TO ROUGH-INS.	GARDCO	107L-16L-700-NWG1-3-UNV		

L BE ACCEPTABLE WITH EQUAL PERFORMANCE OF SPECIFIED EQUIPMENT AND APPROVED BY ENGINEER.

RERS TO ENGINEER 10 DAYS PRIOR TO BID DATE. SHEETS TO OWNER FOR APPROVAL PRIOR TO ORDER.

THAT ANY IRRIGATION SPRINKLER HEAD IS AWAY FROM ANY LIGHT POLE A MINIMUM OF 75' TO AVOID CONSISTENT WATER TO LIGHT POLE. COORDINATE WITH R TO ANY WORK

WON-CORROSIVE MATERIAL (STAINLESS STEEL).

6) ACCEPTABLE MANUFACTURES; PHILIPS, LITHONIA, GOTHAM.

16

18

I

I

14

I

13



300 S. 8th Street, McAllen, Tx 78501 T 956-661-0400 | goero.com








PROJECT NO.: 20042 **ISSUE DATE:** 03.05.21 DRAWN BY: Autho CHECKED BY: SHEET NAME ELECTRICAL LEGEND



Project Status:

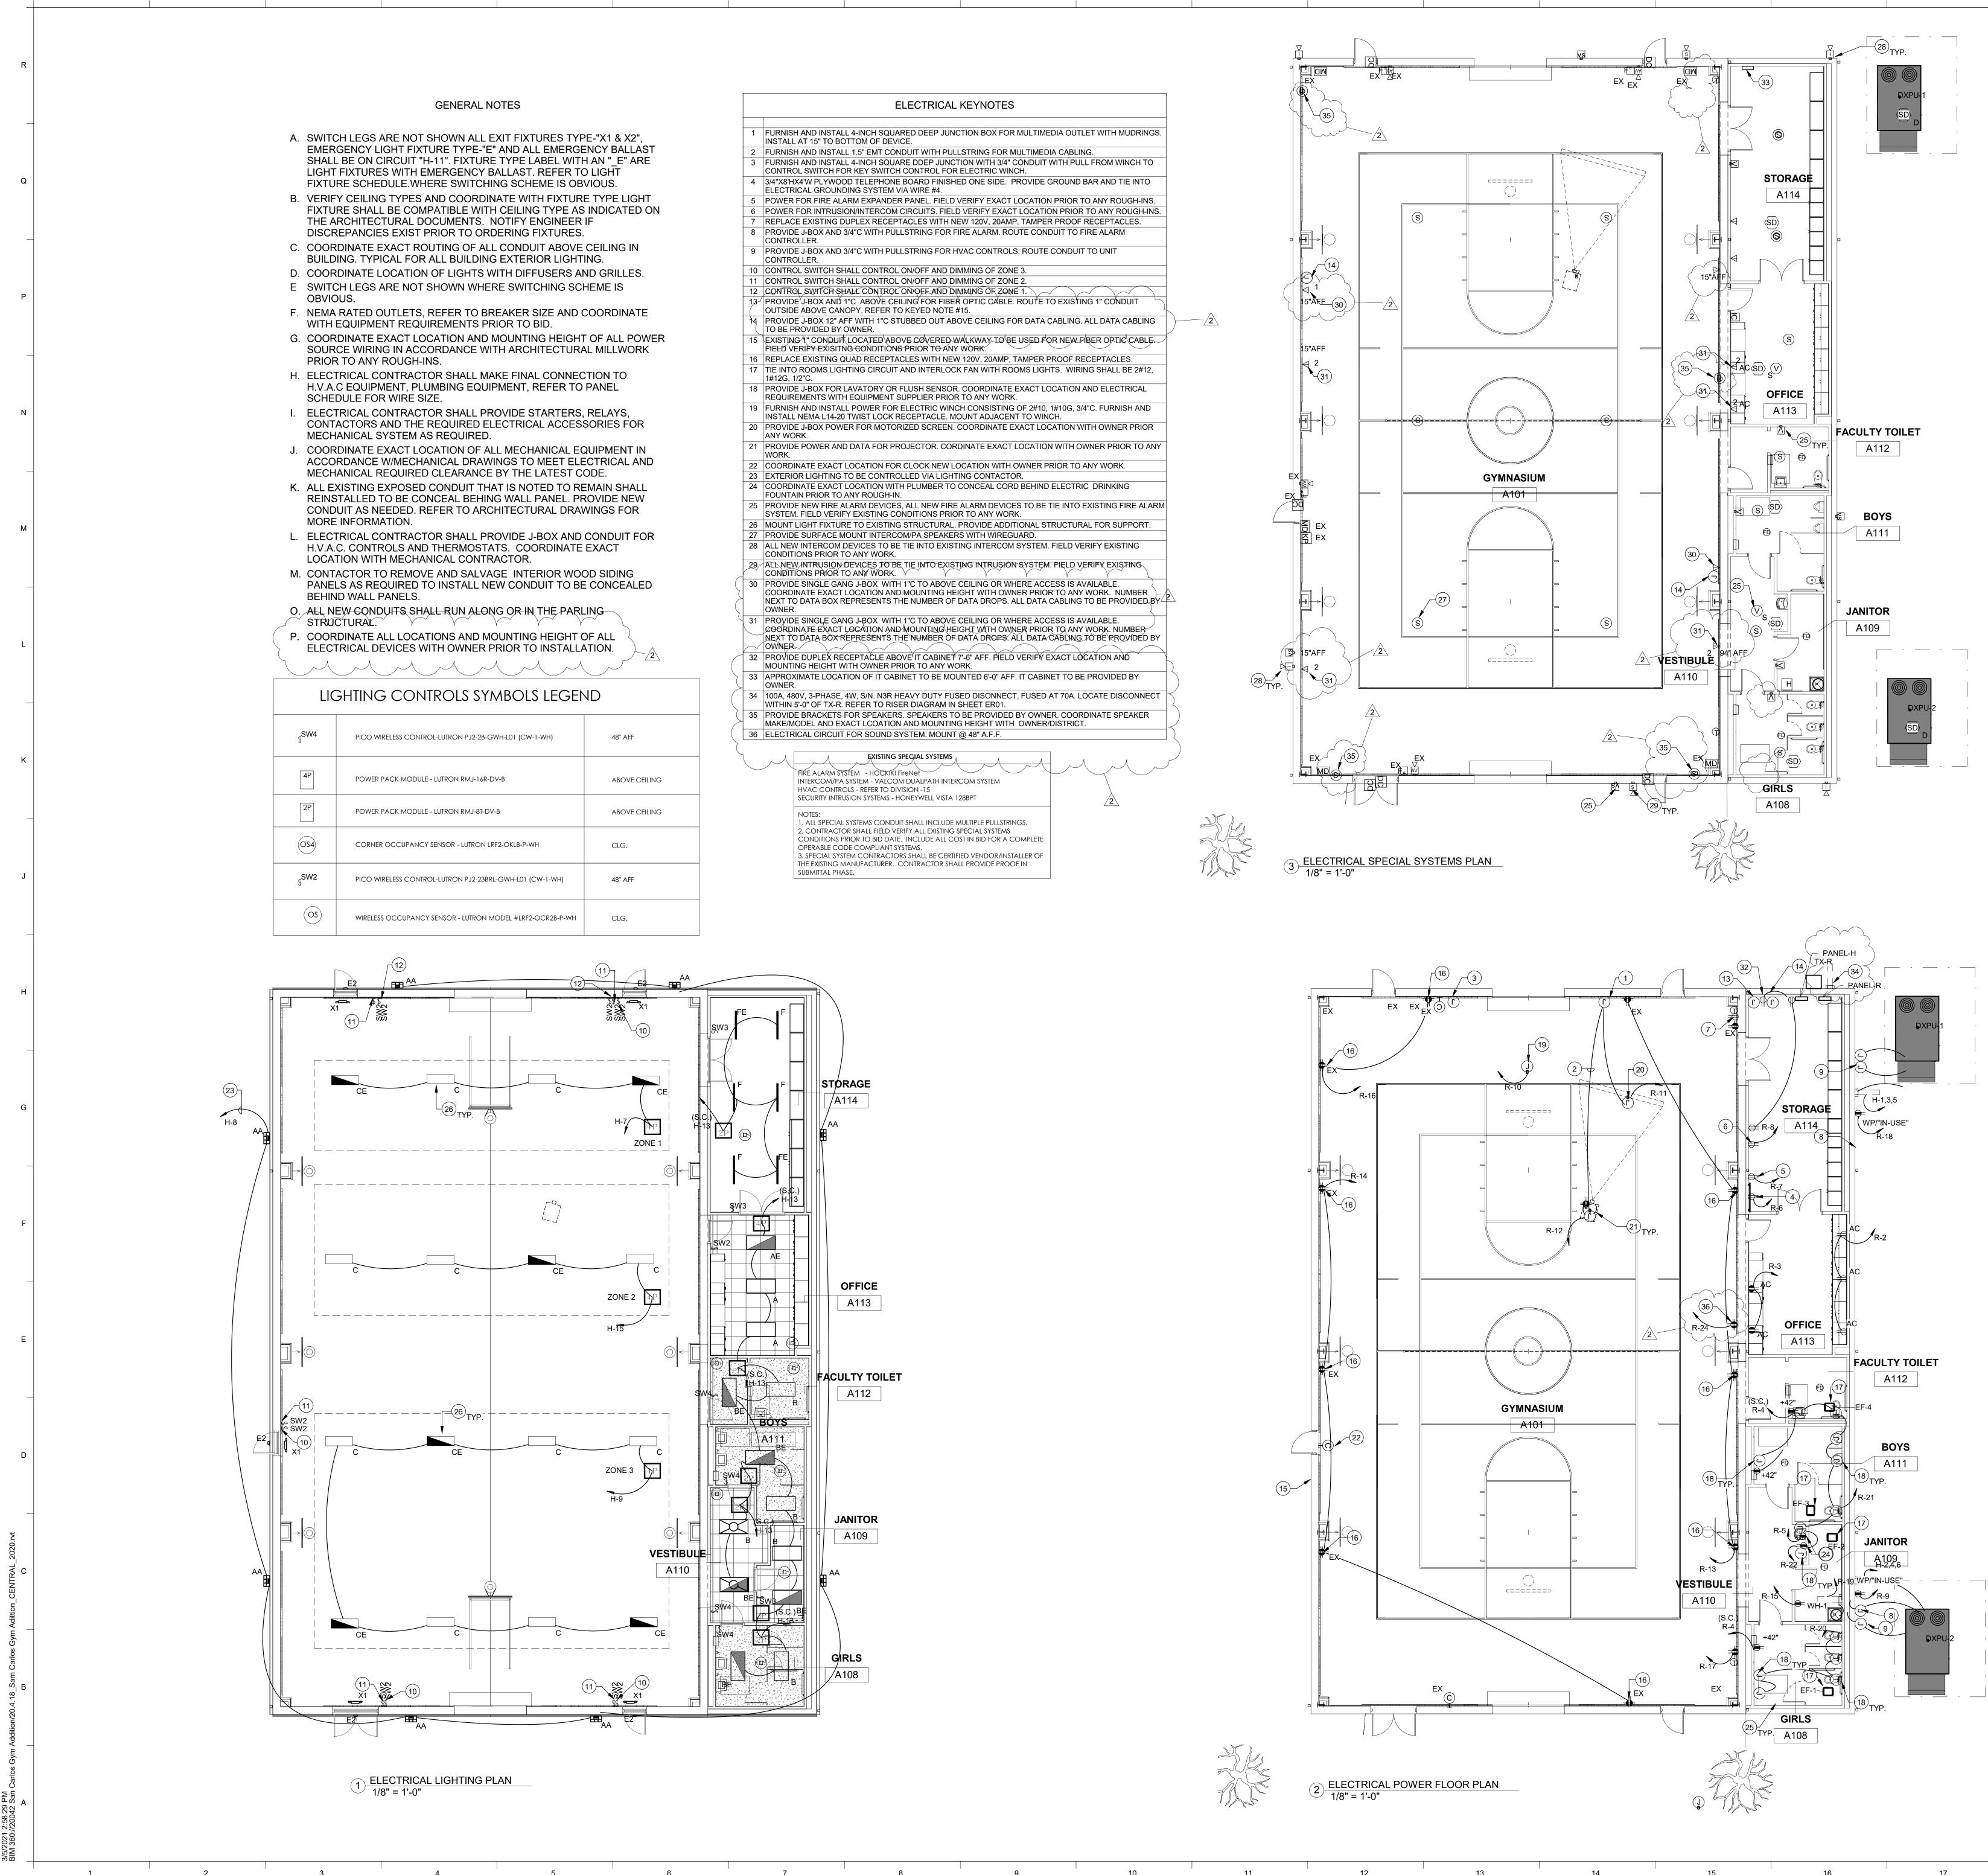



300 S. 8th Street, McAllen, Tx 78501 T 956-661-0400 | goero.com







DISTRIC⁻ ONSOLIDATED INDEPENDENT SCHO 505 S. 83RD ST, EDINBURG TX 78539 \mathbf{O} ר)


PROJECT NO.: ISSUE DATE: 03.05.21 DRAWN BY: CHECKED BY: SHEET NAME ELECTRICAL FLOOR PLAN

Sheet Number



	Branch P	cation:					Valla	490/077 \\/\/a				I.C. Detin			
			STURAG	E A 1 1 4				480/277 Wye				.I.C. Rating	•		
Supply From: Mounting: Surface							Phases:					Mains Type			
		•					Wires:	4				ains Rating	-		
	Enc	closure:	Type 1		1		1					MCB Rating	j: 200 A		
скт	Circuit Description	Trip	Poles	Comments		A		В			Comments	Poles	Trip	Circuit Description	СК
H-1	DXPU-1	70 A	3	4#4, 1#8G,1.5"C	17174 VA	17174 VA					4#4, 1#8G,1.5"C	3	70 A	DXPU-2	H-
Н-3				-			17174 VA	17174 VA							H
H-5									17174 VA	17174 VA					H-
H-7	Lighting	20 A	1	2#12, 1#12G, 1/2"C	240 VA	800 VA					2#10, 1#10G,3/4"C	1	20 A	Lighting	H-
H-9	Lighting	20 A	1	2#12, 1#12G,1/2°C			480 VA	0 VA				1	20 A	Spare	H-1
H-11	EMERGENCY LIGHTING	20 A	ų.	2#10, 1#10G,3/4"C	$\left \right\rangle$				25 VA	0 VA		1	20 A	Spare	H-1
H-13	Lighting	20 A	1	_2#12, 1#12G.1/2"C	/ 890 VA	0 VA						1	20 A	Spare	H-1
H-15	Lighting	20 A	1	2#12, 1#12G,1/2"C			240 VA	0 VA				1	20 A	Spare	H-1
H-17	45 kVA, 277 V/480 V, Three Phase, 4	70 A	3	4#4, 1#8G,1.5"C 2					6550 VA	0 VA		1	20 A	Spare	H-1
H-19					6220 VA	0 VA						1	20 A	Spare	Н-2
H-21							5300 VA	0 VA				1	20 A	Spare	H-2
Н-23	Spare	20 A	1						0 VA	0 VA		1	20 A	Spare	Н-2
H-25	Spare	20 A	1		0 VA	0 VA						1	20 A	Spare	Н-2
H-27	Spare	20 A	1	2			0 VA	0 VA				1	20 A	Spare	H-2
H-29	Spare	20 A	1	<u>/</u>					0 VA	0 VA		1	20 A	Spare	Н-3
H-31	Spare	20 A	1		0 VA	0 VA						1	20 A	Spare	Н-3
Н-33	Spare	20 A	1	\frown			0 VA	0 VA				1	20 A	Spare	Н-3
Н-35	Spare	20 A	1	\sim	1 1				0 VA	0 VA		1	20 A	Spare	Н-3
H-37	1) SPD	30 A	\$	· · · · ·	ZOVA	0 VA						1	20 A	Spare	Н-3
H-39				μ-	\mathbf{P}		0 VA	0 VA				1	20 A	Spare	Н-4
H-41			\						0 VA	0 VA		1	20 A	Spare	Н-4
		Tota	al Load:	\smile \bigcirc	4249	98 VA	4036	68 VA	4092	2 VA					
		Tota	I Amps:		15	4 A	14	6 A	148	B A					
oad Clas	sification		-	Connec	ted Load		Demand Factor			Estimated Demand		Panel Totals			
IVAC				1030	044 VA 100.00%			103044 VA							
Other 2650 V					50 VA 100.00%				2650 VA		Total Conn. Load: 123788 VA				
Receptacle 13920 VA					20 VA	85.92%			11960 VA		Total Est. Demand: 122490 VA				
Power 1500 VA					0 VA		100.00%		1500 VA		Total Conn.: 149 A				
Lighting 2650 VA						125.00%		3313 VA		Total Est. Demand: 147 A					
EMERGENCY LIGHTING 25 VA						100.00% 25 VA									
lotes:]	
	DE INTEGRAL SURGE PROTECTION DEVIC														

4

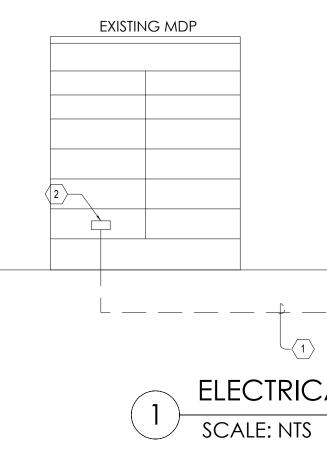

A San 2:58:30 //20042 2021 360: 3/5/2 BIM

2

1

3 4

1

2


Branch Panel: PANEL-R Location: STORAGE A114 Supply From: TX-R Mounting: Surface						Volts: 120/208 Wye Phases: 3 Wires: 4					A.I.C. Rating: 14				
												Mains Typ	e:		
											I	Mains Ratin	g: 100 A		
		Enclosure:	Type 1									MCB Ratin	g: 100 A		
скт	Circuit Description Trip Poles Comments			A B		в	с		Comments Poles		s Trip Circuit Description		скт		
R-1	Receptacle	20 A	1	2#12, 1#12G,1/2"C	600 VA	600 VA					2#12, 1#12G,1/2"C	1	20 A	Receptacle	R-2
R-3	Receptacle	20 A	1	2#12, 1#12G,1/2"C			400 VA	540 VA			2#12, 1#12G,1/2"C	1	20 A	Receptacle	R-4
R-5	E.D.F.	20 A	1	2#12, 1#12G,1/2"C					1200 VA	200 VA	2#12, 1#12G,1/2"C	1	20 A	TELEPHONE	R-6
R-7	FIRE ALARM	20 A	1	2#12, 1#12G,1/2"C	200 VA	200 VA					2#12, 1#12G,1/2"C	1	20 A	INTRUSION/INTERCOM	R-8
R-9	Receptacle	20 A	1	2#4, 1#8G,1.5"C			1500 VA	1200 VA			2#10, 1#10G,3/4"C	1	20 A	ELECTRIC WINCH	R-10
R-11	MOTORIZED SCREEN	20 A	1	2#12, 1#12G,1/2"C					400 VA	400 VA	2#12, 1#12G,1/2"C	1	20 A	PROJECTOR	R-12
R-13	Receptacle	20 A	1	2#8, 1#10G,3/4"C	1600 VA	1600 VA					2#6, 1#10G,1"C	1	20 A	Receptacle	R-14
R-15	Receptacle	20 A	1	2#12, 1#12G,1/2"C			180 VA	800 VA			2#12, 1#12G,1/2"C	1	20 A	Receptacle	R-16
R-17	Receptacle	20 A	1	2#12, 1#12G,1/2"C					400 VA	1500 VA	2#12, 1#12G,1/2"C	1	20 A	Receptacle	R-18
R-19	WH-1	20 A	1	2#10, 1#10G,3/4"C	1500 VA	250 VA					2#12, 1#12G,1/2"@	1	20 A	Other	R-20
R-21	Other	20 A	1	2#12, 1#12G,1/2"C			400 VA	1200 VA			2#10, 1#10G,3/4"C	¥ 1	20 A	Receptacle	R-22
R-23	Spare	20 A	1						0 VA	1200 VA	2#10, 1#10G,3/4"C	1	20 A	Receptacle	R-24
R-25	Spare	20 A	1		0 VA	0 VA					~ / /	~ \ 1	20 A	spare 🔨	R-26
R-27	Spare	20 A	1				0 VA	0 VA					20 A	Spare	R-28
R-29	Spare	20 A	1						0 VA	0 VA		1	20 A	Spare	R-30
R-31	Spare	20 A	1		0 VA	0 VA						1	20 A	Spare	R-32
R-33	Spare	20 A	1				0 VA	0 VA				1	20 A	Spare	R-34
R-35	Spare	20 A	1						0 VA	0 VA		1	20 A	Spare	R-36
R-37	Spare	20 A	1		0 VA	0 VA						1	20 A	Spare	R-38
R-39	Spare	20 A	1				0 VA	0 VA				1	20 A	Spare	R-40
R-41	Spare	20 A	1						0 VA	0 VA		1	20 A	Spare	R-42
Total Load:					65	50 VA	622	0 VA	5300 VA						
					5	56 A 53 A 44 A				44 A					
Load Classification Connected L					cted Load Demand Factor			tor	Estimated Demand			Panel Totals			
Other				26	50 VA	50 VA 100.00%			2650 VA						
Receptacle 139				920 VA 85.92		85.92%	85.92% 11960 VA			Total Conn. Load: 18070 VA					
Power 1500 VA			00 VA	A 100.00%			1500 VA			Total Est. Demand: 16110 VA					
													Total Conn.:	50 A	
										Total	Est. Demand:	45 A			
lotes:				1							1			1	

<u>GENERAL NOTES:</u>

- A. PROVIDE GROUND /BONDING AS INDICATED ON THE NATIONAL ELECTRICAL CODE. B. NAME PLATES SHALL BE PROVIDED FOR ALL ELECTRICAL SWITCH GEAR, PANEL BOARDS,
- LIGHTING CONTACTORS, LIGHTING CONTROL PANELS, ETC.. BY ELECTRICAL CONTRACTOR. C. NEW ELECTRICAL METERING AND SERVICE EQUIPMENT SHALL BE PROVIDED AND INSTALLED ACCORDING TO THE LOCAL POWER UTILITY CO. AND CITY REQUIREMENTS. VERIFY AND COORDINATE WITH POWER UTILITY CO. AND AHJ BEFORE BID AND INSTALLATION.
- D. COMPLY WITH NFPA 70E SAFETY REQUIREMENTS. E. PANELBOARDS WITH MORE THAN 42 CIRCUITS SHALL BE IN ONE CABINET ENCLOSURE,
- UNLESS OTHERWISE NOTED. F. PROVIDE 4"CONCRETE PAD FOR ALL DRY-TYPE TRANSFORMERS.
- G. ALL TWO SECTION PANELBOARDS SHALL BE FEED THRU LUGS. H. CONTRACTOR SHALL BE RESPONSIBLE FOR DELIVERY OF ELECTRICAL SERVICE TO THE NEW BUILDING WITHIN PROJECT SCHEDULE. COORDINATE ALL COST FOR LABOR AND MATERIALS WITH LOCAL ELECTRICAL UTILITY COMPANY PRIOR TO BID. ALL COST ASSOCIATED WITH THE DELIVERY OF ELECTRICAL SERVICE INCLUDING ALL MATERIALS SHALL BE INCLUDED IN BID. TRANSITION OF NEW ELECTRICAL SERVICE SHALL PROCEED IN WEEKENDS OR HOLIDAYS, INCLUDE ALL COST IN BID FOR OVERTIME FROM ELECTRIC UTILITY COMPANY. NO ADDITIONAL PAYMENT WILL BE MADE FOR SERVICE DELIVERY COSTS
- AFTER CONTRACT HAS BEEN AWARDED. I. THE CONTRACTOR SHALL FURNISH SHORT-CIRCUIT AND PROTECTION DEVICE COORDINATE STUDIES WHICH SHALL BE PREPARED BY THE EQUIPMENT GEAR MANUFACTURER AND SUBMITTED AS PART OF THE ELECTRICAL GEAR SUBMITTALS.
- J. THE CONTRACTOR SHALL FURNISH AN ARC FLASH HAZARD ANALYSIS STUDY PER NFPA 70E-STANDARD FOR ELECTRICAL SAFETY IN THE WORKPLACE, REFERENCE ARTICLE 130.3 AND ANEEX D.

ELECTRICAL RISER DIAGRAM KEYED NOTES:

- $\langle 1 \rangle$ route to existing switchboard (MDP). Reuse existing conduit for NeW 4#3/0, ¹ 1#6G. FIELD VERIFY EXISTING CONDITIONS.
- $\langle 2 \rangle$ PROVIDE NEW 200A 3-PHASE, 4W FUSE SWITCH BUCKET IN EXISTING SQUARE-D, QED, 2000 AMP SWITCHBOARD. INCLUDE NEW MOUNT HARDWARE. (3) 100 AMPS, 480V, 3-PHASE, 4W, S/N, N3R, HEAVY DUTY FUSED DISCONNECT, FUSED AT
- $^{\prime}$ 70A. LOCATE DISCONNECT WITHIN 5'-0" OF ASSOCIATED TRANSFORMER. $\langle 4 \rangle$ 1#6G, GROUND ELECTRODE CONDUCTOR, CALDWELD CONNECTION TO BUILDING

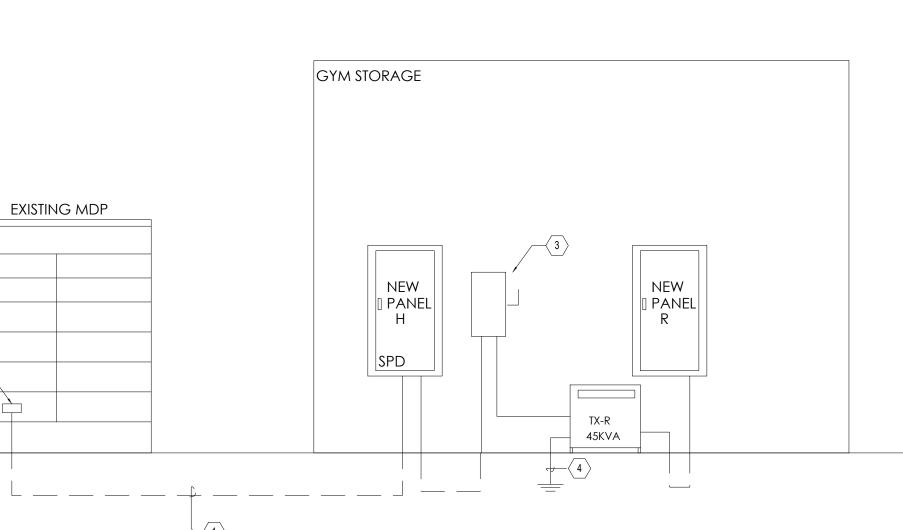

8 9

10

11

ELECTRICAL SCHEMATIC DIAGRAM

5 6 7

DISCONNECT SCHEDULE

DXPU-1,2 100AMP, 3-PHASE, 4W, N3R,480V, S/N, H.D. FUSED DISCONNECT WH-1 30AMP, 3-PHASE, 4W, N1,480V, S/N, N.F., H.D. ROTARY TYPE DISCONNECT NOTE: 1. REFER TO BREAKER SIZE FOR FUSE SIZE.

DRY-TYPE TRANSFORMER SCHEDULE LABEL TRANSFORMER DESCRIPTION TX-R TYPE-DT-3: GENERAL, 45KVA, COPPER WINDINGS,3-PHASE, (P)480V-(S)208/120V,115°RISE,NEMA-3F

NOTE: ALL DRY-TYP TRANSFORMER SHALL BE ENERGY EFFICIENT MODELS AND MEET 2016 ENERGY EFFICIENT REQUIREMENTS.

DESCRIPTION	TOTAL KVA		
LIGHTING	3		
GENERAL POWER	14		
A/C	104		
WATER HEATER	1.5		
	total watts:	123	KVA
	total amps:	147	AMPS
	+25% AMPS:	185	AMPS
	WIRE SIZE AMPS:	200	AMPS

12				
			1	

13

14

19

17

	PRIMARY VOLTAGE FEEDER - 480V, 3	SECONDARY VOLTAGE FEEDER - 120/208V, 3 , 4W
-3R	4#4, 1#8G,1 1/2	4#2, 1#8G,2"C

12

13

ļ

14

I

15

16

17

18

19



300 S. 8th Street, McAllen, Tx 78501 T 956-661-0400 | goero.com






/



DISTRIC⁻ С CONSOLIDATED INDEPENDENT SCHO 505 S. 83RD ST, EDINBURG TX 78539 RG

m

ED

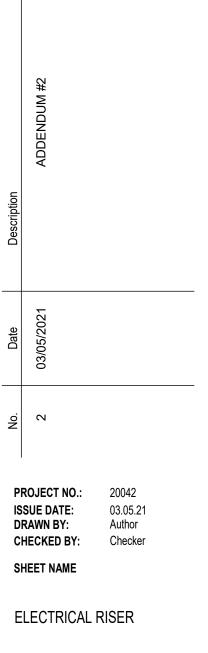

Sheet Number



Project Status: